

KANSAS


FORM 51 5M 10-41 PETROL

McPherson

Section 19 Township 17 Range 3-W

Well No. #2 Rundberg

Company Dickey

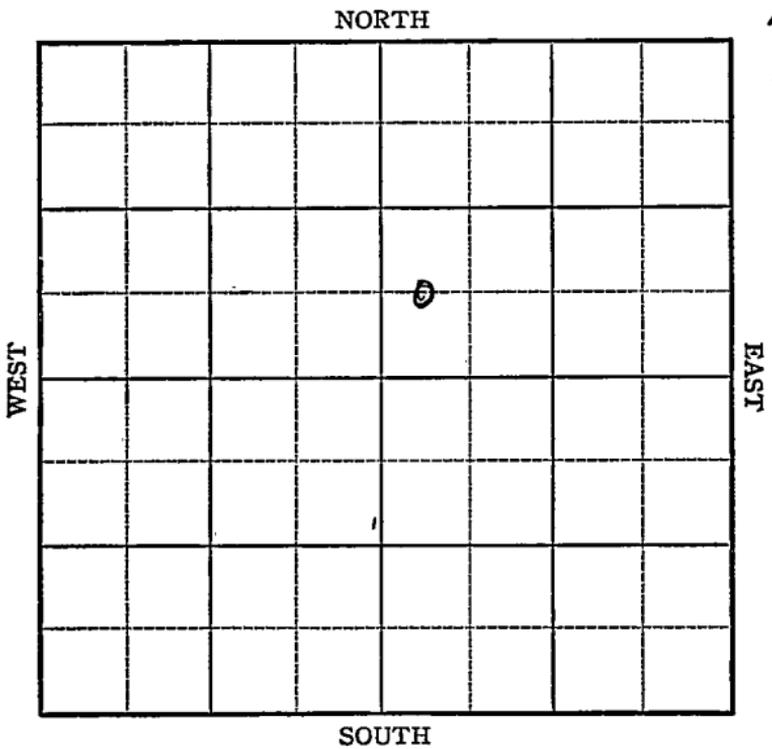

Sec. 19 Twp. 17 R. 3-W

Well No. #2 Rundberg Farm

Dickey Company

(Lindsborg)


_____ Ft. from N. Line

660 Ft. from S. Line

_____ Ft. from E. Line

330 Ft. from W. Line

Elev. 1339

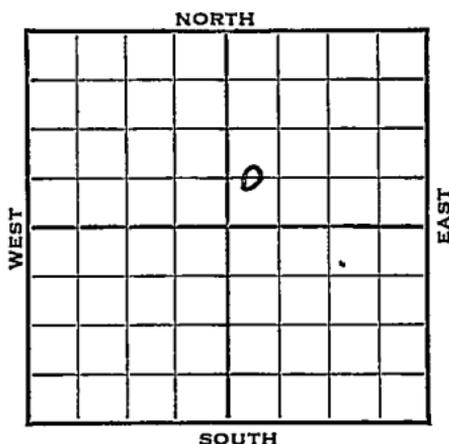

1942

REPORT

7/15	Location
7/22	10" @ 141 8" @ 340'
	940 Lost Circulation
7/29	Topeka 1875' Lans. 2269'
	Miss. 2905 Drlg. 2965'
8/5	Viola 3362 T.D. 3363 $\frac{1}{2}$
	5" - 3362 RUST
8/12	2000 acid 1700' oil 14 hrs.
8/19	TD 3370'
8/27	"
9/2	"
9/9	"
9/16	"
9/23	"
9/30	Shut in.
10/7	"
10/14	"
10/21	"
10/28	"
11/11	5" @ 3362
	Viola 3362
	T.D. 3370'
	2000 Gals. acid
	Pump 42 Pot.
	Gravity 36

COMPLETED

McPherson

KANSAS

Map No. 42 Sec. 19 Twp. 17 R. 3WWell No. 2 RundbergDickey

Company

FIRST REPORT

Contractor

C W L S W N E

_____ Ft. from N. Line

660 Ft. from S. Line

_____ Ft. from E. Line

330 Ft. from W. Line

SECTION PLAT

		o	

LINDSBORG POOLLocation XXX

Rig up _____

Drilling and Remarks:

RECORD

Cased _____ in., _____ ft.

Sand _____

Gas _____

Oil _____

Total Depth _____

PRODUCTION

1st 24 hrs. Nat. _____

1st 24 hrs. after shot _____

Gas _____ Cu. Ft.

Dry Hole _____

Abandoned _____

Date

JUL 15 1942 19S. J. LEWIS Scout

KANSAS

McPherson

Map No. 42 Sec. 19 Twp. 17 R. 3W.Well No. 2 RundbergDickey CompanyCOMPLETED Contractor

O WL S W NE

SECTION PLAT

 Ft. from N. Line660 Ft. from S. Line Ft. from E. Line330 Ft. from W. Line

LINDSBORG POOL

Location Rig up

Drilling and Remarks:

Viola 23625" @ 23622000 acidPump. 42 2 1/236 1/2

RECORD

Cased in., ft.Sand Gas Oil Total Depth 3370

PRODUCTION

1st 24 hrs. Nat. 1st 24 hrs. after shot Gas Cu. Ft.Dry Hole Abandoned

Date

NOV 11 1942

19

S. J. LEWIS

Scout