

KANSAS

McPherson


Form 51—5M—7-40—Palace


Section 19 Township 17 Range 1-W

Well No. #3 Jones

Company Stelbar

NORTH Roxbury Pool

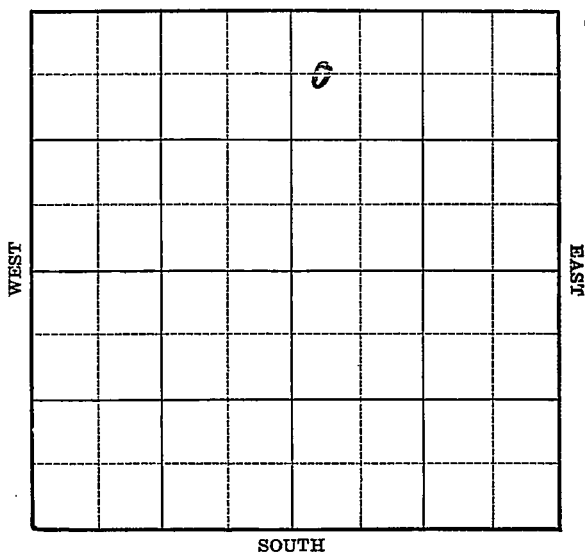

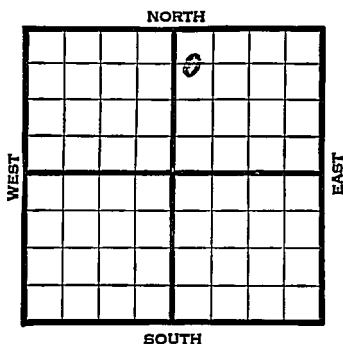[illegible]

Map No. 42 Sec. 19 Twp. 17 R. 1WWell No. 3 JonesStelbar Company Contractor

FIRST REPORT

C W L NW NE

660 Ft. from N. Line Ft. from S. Line Ft. from E. Line330 Ft. from W. Line

SECTION PLAT

ROXBURY POOL

Location Rig up

Drilling and Remarks:

10" - 179 WCC

RECORD

Cased in., ft.Sand Gas Oil Total Depth

PRODUCTION

1st 24 hrs. Nat. 1st 24 hrs. after shot Gas Cu. Ft.Dry Hole Abandoned

Date

SEP 18 194019S. J. LEWIS Scout

Map No. 42 Sec. 19 Twp. 17 R. 1WWell No. 3 JonesStelbar Company

Contractor

COMPLETED

C W L NW NE

SECTION PLAT

660 Ft. from N. Line Ft. from S. Line Ft. from E. Line330 Ft. from W. Line

ROXBURY POOL

		0	

Location Rig up

Drilling and Remarks:

*Miss 2668**5" @ 2668**2000 acid**Pump. 1905 P.M.*

RECORD

Cased in., ft.Sand Gas Oil Total Depth 2682

PRODUCTION

1st 24 hrs. Nat. 1st 24 hrs. after shot Gas Cu. Ft.Dry Hole Abandoned

Date

OCT 9 1940S. J. LEWIS Scout