

KANSAS

Form 51-5M-7-40-Palace


McPherson

Section 19 Township 17 Range 1-W

Well No. #3 Zietlow

Company Westgate Greenland

NORTH Roxbury Pool

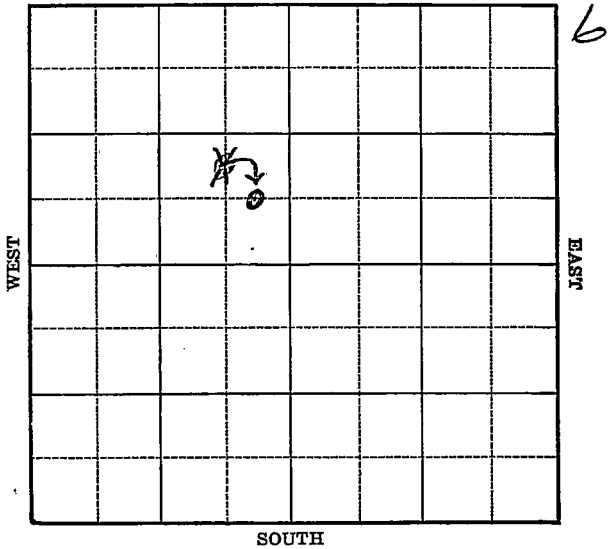

Sec. 19 Twp. 17 R. 1-W

Well No. #3 Zietlow Farm

Westgate Greenland Company

(Roxbury)


_____ Ft. from N. Line

660
~~990~~ Ft. from S. Line

330
~~660~~ Ft. from E. Line

_____ Ft. from W. Line

Elev. 1358
~~1382~~

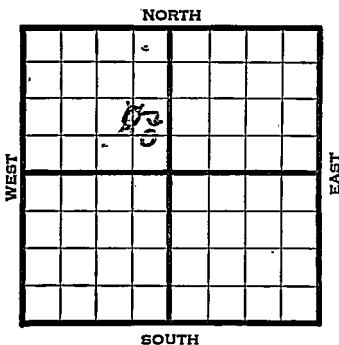

1940	REPORT
11/20	Derrick.
11/27	"
12/5	"
12/12	"
12/19	"
12/26	"
1941	
1/2	"
1/9	"
1/16	"
1/23	"
1/30	"
2/6	"
2/13	"
2/20	"
2/27	"
3/6	"
3/13	"
3/20	10" - 153' Miss. 2660'
	7" - 27 58' RUST.
3/27	" " "
	OVER

1941
4/2

Miss. 2660'

7" - 2658'

T.D. 2672'

2000 acid.

Potential 1945 bbls., pump &
flow.

Plus 3% water.

34. Gravity

COMPLETED

Map No. 42 Sec. 19 Twp. 17 R. 1WWell No. 3 ZietlowWestgate Greenland

Company

Contractor

FIRST REPORT

C N L SE NW

 Ft. from N. Line990 Ft. from S. Line660 Ft. from E. Line Ft. from W. Line

ROXBURY POOL

SECTION PLAT

	o		

Location Rig up

Drilling and Remarks:

Derrick

RECORDCased in., ft.Sand Gas Oil Total Depth **PRODUCTION**1st 24 hrs. Nat. 1st 24 hrs. after shot Gas Cu. Ft.Dry Hole Abandoned

Date

NOV 20 1940

19

S. J. LEWIS

Scout

Misc. Small Maps	<i>RAM</i>
Cards	<i>RAM</i>
Tracing	<i>JM</i>
France Map	<i>JM</i>

Map No. 42 Sec. 19 Twp. 17 R. 1WWell No. 3 ZietlowWestgate-Greenland CompanyCORRECTION Contractor

SECTION PLAT

C E L S E N W

 Ft. from N. Line660 Ft. from S. Line330 Ft. from E. Line Ft. from W. Line

ROXBURY POOL

		o	

Location Rig up

Drilling and Remarks:

Skid Rig from

C N L S E N W

RECORD

Cased in., ft.Sand Gas Oil Total Depth

PRODUCTION

1st 24 hrs. Nat. 1st 24 hrs. after shot Gas Cu. Ft.Dry Hole Abandoned

Date

MAR 12 1941 19

S. J. LEWIS Scout

DALL
Nice Small Maps
Cards
Tracing
France Map
Scrub Map
Moody Map
Go In of Light
Moody Map

Map No. 42 Sec. 19 Twp. 17 R. 1WWell No. 3 ZietlowWestgate Greenland CompanyCOMPLETED Contractor

C E L SE NW

 Ft. from N. Line660 Ft. from S. Line330 Ft. from E. Line Ft. from W. Line

ROXBURY POOL

SECTION PLAT

Location Rig up

Drilling and Remarks:

*Shs 2660.**7" @ 2658.**2000 @ 2650**Pump & Flow 1945**Plus 3% Water.**34 @ 2658*

RECORD

Cased in., ft.Sand Gas Oil Total Depth: 2672

PRODUCTION

1st 24 hrs. Nat. 1st 24 hrs. after shot Gas Cu. Ft.Dry Hole Abandoned

Date

APR 2 1941 19 S. J. LEWIS Scout

Misc Small Maps
Cards
Tracing
France Map
Scarborough Map
Moody Map
Geological Dept.
Moody Flat Book

DAVE
DAVE
DAVE
DAVE
DAVE
DAVE