


Map No. KANSAS Sec. 2 Twp. 17 R. 10^w

Well No. 1-Phelan Farm
Tom Palmer et al Company

 Ft. from N. Line
330 Ft. from S. Line
330 Ft. from E. Line
193 1/2 Ft. from W. Line
Our lease - NW 1/4

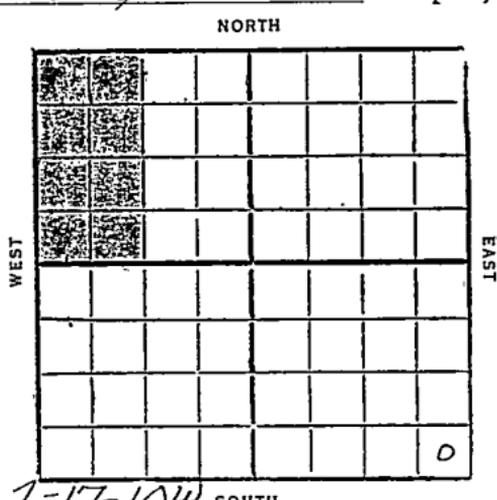

193 1/2 NW 1/4 Sec. 2-17-10^w SOUTH

Date	REPORT
8/12	Loc
8/19	
8/26	Bldg req
9/2	req
9/9	run up
9/16	20"-150'
9/23	Spdg. ✓ WIR 15 1/2"-510'
9/30	Dreg 1485
10/7	12 1/2"-1650 Dreg 1900
10/14	" 2045'
10/21	10"-2385 Dreg 2415'
10/28	1 barrel water 3020-25 Dreg 3070'
11/2	Set 8 1/4" at 3220' - Topped Conglomerate 3272 - Small show at 2300-05' - Set 6" liner at 3305. Top Siliceous lime at 3309 (subject to correction) Had 150' oil at 3317-20. Small increase from 3328-32. T.D. 3344 Filling with water

(Telephone)

11/4- Cased 8" 3220
Top Conglomerate 3272
Show 3300-05'
Top Silic lime 3309
200' oil 3314-19
Small increase oil
and show water 3328-32
T.D. 3344' HFW
Dry & abandon

Ellsworth

KANSAS

Map No. _____ Sec. 2 Twp. 17 R. 10 ^W

Well No. 55 1 *Phelan*

Tom Palmer et al Company

Contractor

FIRST REPORTS

SECTION PLAT

_____ Ft. from N. Line

330 Ft. from S. Line

330 Ft. from E. Line

_____ Ft. from W. Line

Location ✓

Rig up _____

Drilling and Remarks: _____

RECORD

Cased _____ in., _____ ft.

Sand _____

Gas _____

Oil _____

Total Depth _____

PRODUCTION

1st 24 hrs. Nat. _____

1st 24 hrs. after shot _____

Gas _____ Cu. Ft.

Dry Hole _____

Abandoned _____

Date

AUG 1 2 1931

CHAS. L. SHERWOOD

192

Scout

Ellsworth

35 Map No. **KANSAS** Sec. 2 Twp. 17 R. 10 W

Well No. 1 *Phelan*

Tom Palmer et al Company

Contractor

SECTION PLAT

COMPLETED

..... Ft. from N. Line

330 Ft. from S. Line

330 Ft. from E. Line

..... Ft. from W. Line

ABANDONED

Location.....

Rig up.....

Drilling and Remarks:

Top Cong 3772
Shaw 3300-3305
Top Siliceous 3309
200' li 3314-19
Small inc & Shaw
Water 3328-32

RECORD

Cased 8 in., 3220 ft.

Sand.....

Gas.....

Oil *NFW*.....

Total Depth 3344

PRODUCTION

1st 24 hrs. Nat.....

1st 24 hrs. after shot.....

Gas..... Cu. Ft.

Dry Hole.

Abandoned.

Date

NOV 4 1931 CHAS. L. SHERWOOD Scout