

Sec. 2 Twp. 17 R. 10-W


Well No. #3 Phelan Farm
Atlantic Company

330 Ft. from N. Line

_____ Ft. from S. Line

_____ Ft. from E. Line

990 Ft. from W. Line

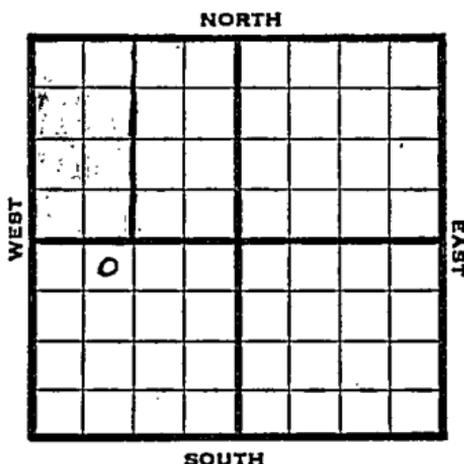

NE NW SW

OFFSET

1945 Elev. 1816 REPORT

- 11/7 RUR
- 11/14 8" @ 320
Drlg. 2755'
- 11/23 Arbuckle 3268' Lans 2945
TD 3282'
7" @ 3277'
Show oil
- 11/26 Waiting on tools (Telegram)
Top Arbuckle 3268'
5" @ 3277'
TD 3282'
Drilled plugs had very small show oil
in 12 hours
1000 acid thru casing
Filled 100' oil per hours - no water
Running tubing to acidize w/2000 (Tel)
- 11/28 TD 3284
1000 acid.
Swab 2 1/2 oil per hr, 2000 acid.
- 12/5 Waiting on pumping unit
- 12/12 " " " "
- 12/20 " " " "
- 12/29 " " " "
- 1946
- 1/10 Pump 2 1/2 oil per hr 11 hours.
- 1/17 1200 acid.
- 1/23 Pump potential- 93 bbls. oil plus
2% water. (Telegram)

3268
1816
-1452

OVER

1946

1/23

Arb. 3268

5" @ 3277

4200 acid

TD 3284'

Pump 93 oil plus 2% wtr. Pot.

Grav. 42.0

COMPLETED

KANSAS

Kansas Pool Name Bloomer

Map No. FS Sec. 2 Twp. 17 R. 10W

Well No. 3 Phelan

Atlantic Company

FIRST REPORT

Contractor

NE NW SW


SECTION PLAT

330 Ft. from N. Line

_____ Ft. from S. Line

_____ Ft. from E. Line

990 Ft. from W. Line

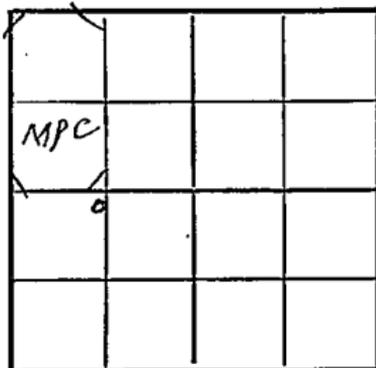

Ellsworth County

Location *opposed*

Rig up _____

Drilling and Remarks:

RUR

RECORD

Cased _____ in., _____ ft.

Sand _____

Gas _____

Oil _____

Total Depth _____

PRODUCTION

1st 24 hrs. Nat. _____

1st 24 hrs. after shot _____

Gas _____ Cu. Ft.

Dry Hole _____

Abandoned _____

Date

NOV 7 1945 19

S. J. LEWIS

Scout

KANSAS ~~Kansas~~ Pool Name StoltenbergMap No. 33 Sec. 2 Twp. 17 R. 10WWell No. 3 PhelanAtlantic CompanyCOMPLETED Contractor

NE NW SW

E11876
SECTION PLAT330 Ft. from N. Line Ft. from S. Line Ft. from E. Line990 Ft. from W. Line

0			

Ellsworth County

Location _____

Rig up _____

Drilling and Remarks:

Cr 3268
5' @ 3277
4200 acid
Pump. 930' L +
2 1/2 Water Prod
420' Gr

RECORD

Cased _____ in., _____ ft.

Sand _____

Gas _____

Oil _____

Total Depth 3284

PRODUCTION

1st 24 hrs. Nat. _____

1st 24 hrs. after shot _____

Gas _____ Cu. Ft.

Dry Hole _____

Abandoned _____

Date

JAN 23 1946

19

S. J. LEWIS

Scout