


Section 2 Township 17 Range 10W.

Well No. #3 Phelan

Company Derby et al

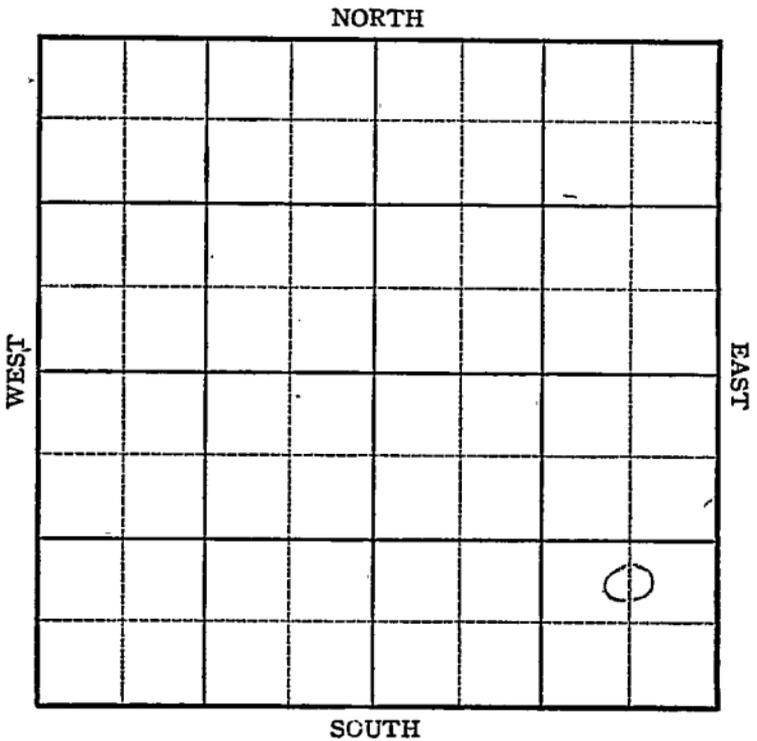

Sec. 2 Twp. 17 R. 10W

Well No. #3 Phelan Farm

Derby et al Company


Stoltenberg

_____ Ft. from N. Line

990 Ft. from S. Line

660 Ft. from E. Line

_____ Ft. from W. Line

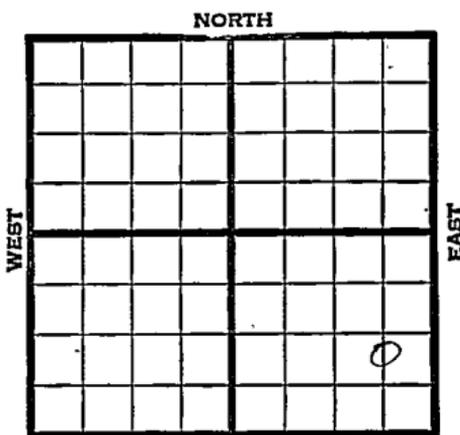

CNL SE SE 80w. 1818

REPORT

1945

3/28	SH				
4/5	8" @ 328				
	Drlg. 2355				
4/12	Lans	2942			
	Cong	3259			
	Arb	3289			
	TD 3304 Sat.				
	5" @ 3290'	RUST			
4/20	" " " " "				
4/27	" " " " "				
5/3	9 qts. 3295-3304 SSO				
	1500 acid.				
	Drlg. 3312				
5/10	TD 3375				
	PB 3308				
	20 qts. 3297-3307	1850'	fluid		
5/17	" " " " "				
5/24	" " " " "				
5/31	" " " " "				
6/13	Arb	3289			
	5" @ 3290'				
	PB 3308				
	20 qts 3297-3307				
	Pump 33 oil & 65% Water Pot.				
	42 4 Gr.				
	TD 3375'				

COMPLETED

