


Section 2 Township 17 Range 10-W

Well No. #4 Seimsen

Company Iron Drlg.

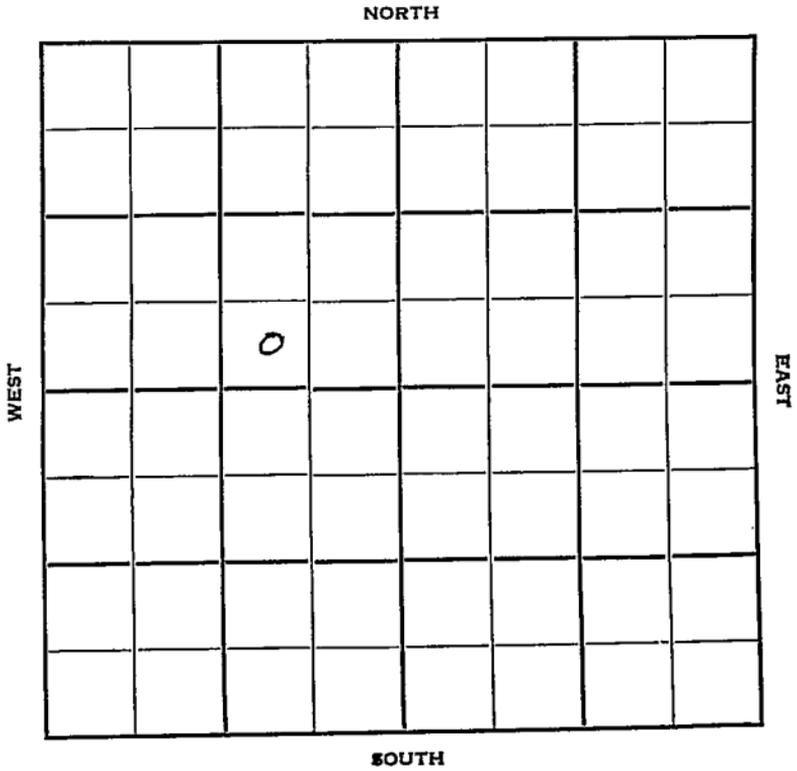

KANSAS  
17

Ellsworth  
10-W

Sec. 2 Twp. \_\_\_\_\_ R. \_\_\_\_\_

Well No. #4 Seimsen Farm \_\_\_\_\_

Iron Drlg. Company \_\_\_\_\_

Iron Drlg Contractor \_\_\_\_\_

Stoltenberg


\_\_\_\_\_ Ft. from N. Line

330 Ft. from S. Line

990 Ft. from E. Line

\_\_\_\_\_ Ft. from W. Line

SW SE NW

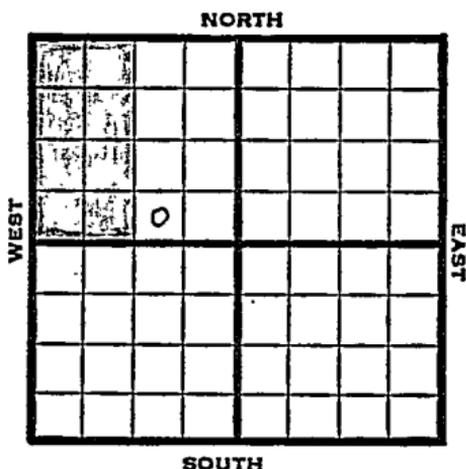

1950

Elev. 1817 REPORT

10/18

Spud 10-9-50  
8 5/8" @ 250  
Anhy 560  
drlg 2985

1951

Have written for late information

1/4

Spud 10/9/50  
Oil well TD 3296  
8-5/8" @250

1/31

Anhy 560 Top 2750 Lans 2936  
Arb 3255  
TD 3262

5 1/2" @3256 SSO 100 A 15 goph  
DD 3290 50 qt/ 3266-86 500 A 1 1/2 bopd  
2000 A P/14 bwph 3 bo DD 3296  
water PB 3292 45 bo 28 bwpd PB 3290  
Comp. 20 bo 130 bwpd

**COMPLETED**


County Ellsworth State Kansas

Sec. 2 (Blk. 17) (Sur. 10W) (Twp.) (Rge.) Map No.

Operator Iron Drlg.

Well No. 4 Farm Seimsen

Elev. \_\_\_\_\_ Location SW SE NW

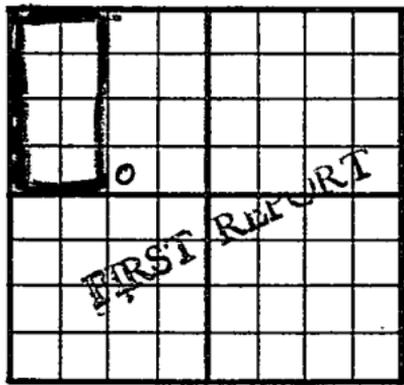

330 Ft. From S Line NW

990 Ft. From E Line Quarter

1st. Report OCT 18 1950

Completion \_\_\_\_\_

Remarks \_\_\_\_\_

Iron Drlg. - Contr.

Spudding Date 10-9-50

Drlg. Data Stoltenberg Pool

8 5/8" @ 250 Anhy 560 drlg. 2985


County Ellsworth State Kansas

Sec. 2 (Blk. 17) (Twp. 17) (Sur. 10W) (Rge. 10W) Map No.

Operator Iron Drlg.

Well No. 4 Farm Seimsen

Elev. 1817 Location SW SE NW

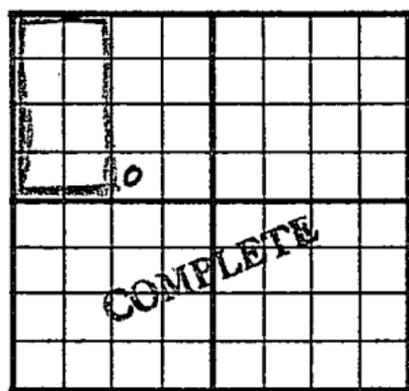

330 Ft. From S Line NW

990 Ft. From E Line Quarter

1st. Report

Completion JAN 31 1951

Remarks Stoltenberg Pool

Iron Drlg. - Contr.

Spudding Date 10-9-50

Drlg. Data Oil well TD 3296

8 5/8" @ 250 Anhy 560 Top. 2750

Lans. 2936 Arb. 3255 TD 3262

5 1/2" @ 3256 SSo 100 A 15 goph

DD 3290 50 at/ 3266-86 500 A 1 1/2 boph

2000 A P/ 14 bwph 3 bo DD 3296

water PB 3292 45 bo 28 bwpd PB 3290

Comp. 20 bo 130 bwpd

J. E. TYRA