


Section 2 Township 17 Range 10W

Well No. 1 Siemsen "A"

Company Iron Drlg.

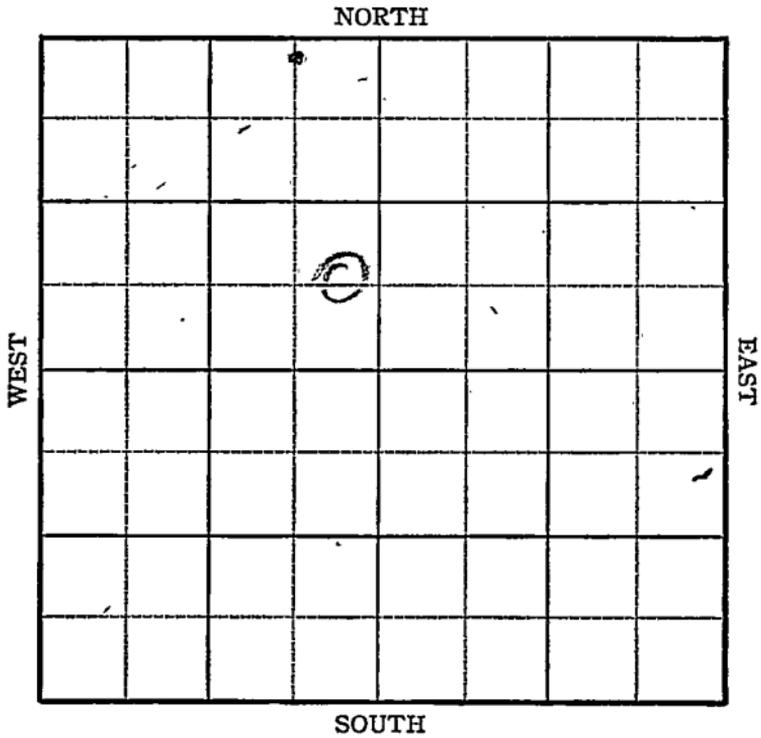

KANSAS


Ellsworth

Sec. 2 Twp. 17 R. 10W

Well No. 11 Siemsen "A" A Farm  
Iron Drlg. Company

Stoltenberg

         Ft. from N. Line  
660 Ft. from S. Line  
330 Ft. from E. Line  
         Ft. from W. Line

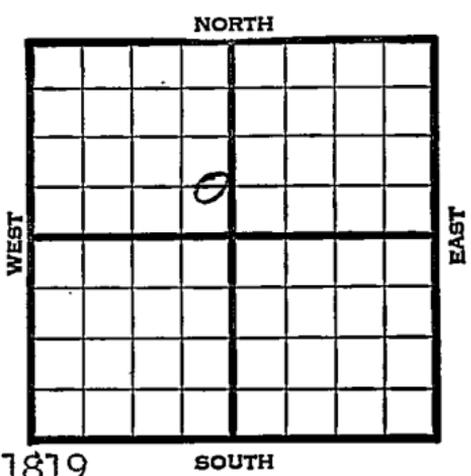

C E L SE NW Elev. 1819 SOUTH

1945

REPORT

6/27	8" @ 175' <u>anhy 590</u> 1430
7/3	Drlg. 2817
7/11	Lans 2930 BKC 3200 Cong 3251 Arb. 3257 & 3260 TD 3260'
7/19	5" @ 3259' ust TD 3287 2000 acid. 3/4" oil per hr
7/26	1500 acid. Pump 39 oil in 24 hrs.
8/1	Arb. 3257 5" @ 3259' T.D. 3287' 3500 acid Pump 39 pot. Gravity 42

COMPLETED


Kansas Pool Name StoltenbergMap No. 55 Sec. 2 Twp. 17 R. 10WWell No. 1 Siemens "A"

Iron Drlg. \_\_\_\_\_ Company \_\_\_\_\_

Contractor \_\_\_\_\_

FIRST REPORT  
C E L SE NW

## SECTION PLAT

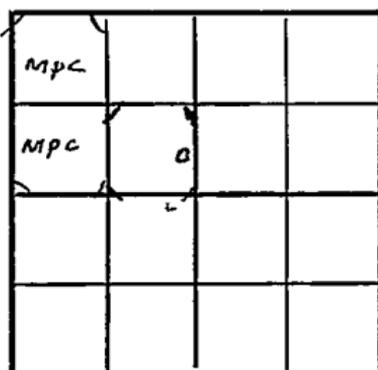

\_\_\_\_\_ Ft. from N. Line

660 Ft. from S. Line330 Ft. from E. Line

\_\_\_\_\_ Ft. from, W. Line

*Hot file*Ellsworth County

Location \_\_\_\_\_

Rig up \_\_\_\_\_

Drilling and Remarks:

8"-175  
any 590  
1430

## RECORD

Cased \_\_\_\_\_ in., \_\_\_\_\_ ft.

Sand \_\_\_\_\_

Gas \_\_\_\_\_

Oil \_\_\_\_\_

Total Depth \_\_\_\_\_

## PRODUCTION

1st 24 hrs. Nat. \_\_\_\_\_

1st 24 hrs. after shot \_\_\_\_\_

Gas \_\_\_\_\_ Cu. Ft.

Dry Hole \_\_\_\_\_

Abandoned \_\_\_\_\_

Date

JUN 27 1945

19

S. J. LEWIS

Scout

**KANSAS**  
Kansas

Pool Name Stoltenberg

Map No. 75 Sec. 2 Twp. 17 R. 10W

Well No. 1 Siemsen "A"

Iron Drlg. Company

**COMPLETED**

Contractor

C E L SE NW

*E 11879*  
**SECTION PLAT**

		0	

         Ft. from N. Line

660 Ft. from S. Line

330 Ft. from E. Line

         Ft. from W. Line

Ellsworth County

Location                                 

Rig up                                 

Drilling and Remarks:

*CR 3257*

*5" 3259*

*3500 acal*

*Aug 39 PDX*

*42 2/3*

Date

**RECORD**

Cased          in.          ft.

Sand                                 

Gas                                 

Oil                                 

Total Depth 3287

**PRODUCTION**

1st 24 hrs. Nat.                                 

1st 24 hrs. after shot                                 

Gas                                  Cu. Ft.

Dry Hole                                 

Abandoned                                 

AUG 1 1945 19

S. J. LEWIS Scout