

KANSAS

FORM 51 25M 3-49 PETROL

Ellsworth

Section 2 Township 17 Range 10-W


Well No. #13 Stratman

Company N C R A

NORTH

WEST

EAST

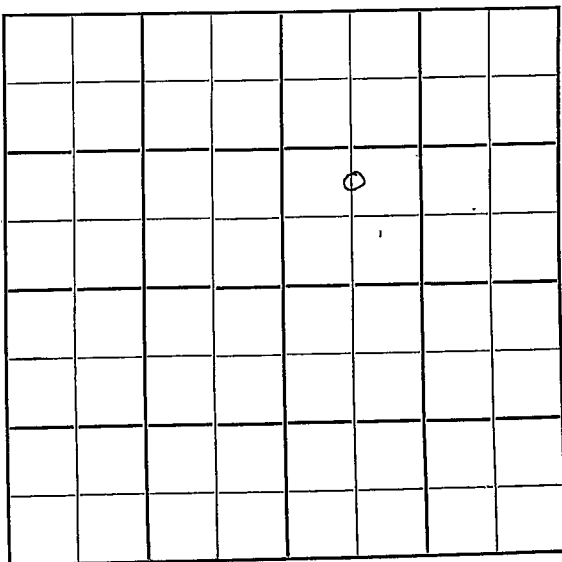

SOUTH

Sec. 2 Twp. 17 R. 10W

Well No. #13 Stratman Farm

NCRA Company

Contractor

Ft. from N. Line


990' Ft. from S. Line

Ft. from E. Line

525' Ft. from W. Line

C N L SW NE

Oil Well

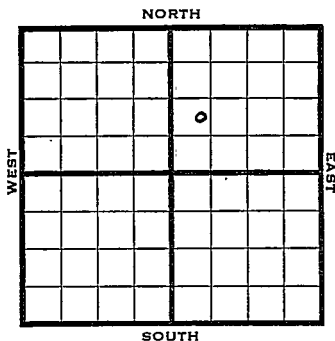

1950

Elev 1822

REPORT

8/9 8-6/8" @ 248'
WOC

9/13 Spud 8-6-50
8 5/8" @ 248
Br lime 2929
Simp 3258
5" @ 3263

Lans 2943
Arb 3261

TD 3283
15 qt 3276-88
10 goph 5 hr

500 A 10 goph 7 hr 1500 A
S/54 bo 15 hr Comp 82 bo 3 bwpd
TD 3293

Completed

COMPLETED

County Ellsworth State KansasSec. 2 (Blk.) 17 (Sur.) 10W Map No.Operator H C R AWell No. 13 Farm StratmanElev. Location C N L SW NE

FIRST REPORT

990 Ft. From S Line NE525 Ft. From W Line Quarter1st. Report AUG 9 1950

Completion


Remarks

Spudding Date 8-6-50

Drig. Data

8 6/8" @ 248 WOC

J. E. TYRA

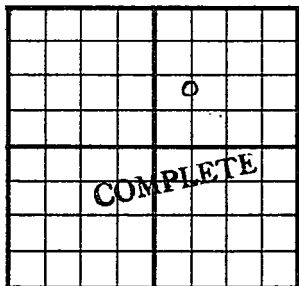County Ellsworth State KansasSec. 2 (^{Blk.}_{Twp.}) 17 (^{Sur.}_{Rge.}) 10W Map No.Operator N C R AWell No. 13 Farm StratmanElev. 1822 Location C N L SW NE990 Ft. From S Line NE525 Ft. From W Line Quarter1st. ReportCompletion SEP 13 1950RemarksStoltenberg PoolSpudding Date 8-6-50Drlg. Data Oil well TD 32838 5/8" @ 248 Br. lime 2929 Lans. 2943Simp. 3258 Arb. 3261 5" @ 3263TD 3283 15 qt. 3276-88 10 goph 5 hr.500 A 10 goph 7 hr. 1500 AS/ 54 bo 15 hr. Comp. 82 bo 3 bwpd

J. E. TYRA