

# KANSAS


Form 51-5M-7-39-Palace

Ellsworth

Section 2 Township 17 Range 10-W

Well No. #1 Stratmann ~~WB~~ #2

Company Pryor & Lockhart

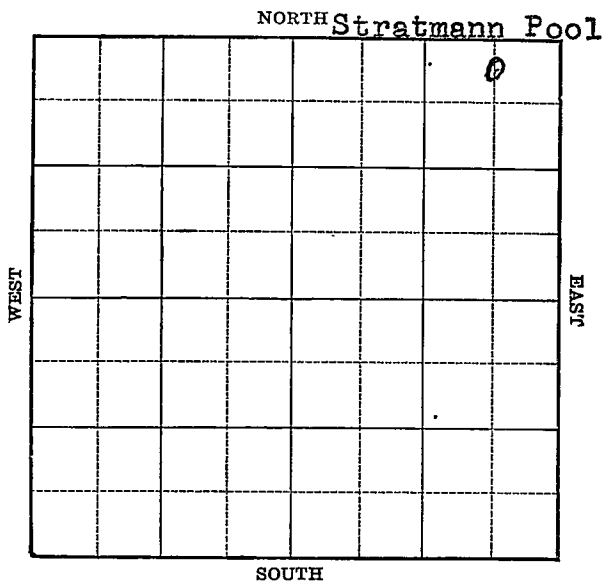

KANSAS

Ellsworth

Sec. 2 Twp. 17 R. 10-WWell No. #1 Stratmann #2 Farm

Pryor &amp; Lockhart

Company

(Stratmann)

330

Ft. from N. Line


Ft. from S. Line

660

Ft. from E. Line

Ft. from W. Line

Elev. 1829

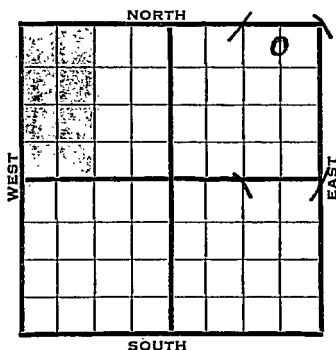

1940

## REPORT

5/22

Location

*1/4 N off.*

5/29

Surface hole.

*3000 ft. deep*

6/5

Dlg. 2635

(Tel) 10" - 232'

6/10

Top Arbuckle 3272 T.D. 3275

Show oil in cuttings

Running 7" 3272 (Tel)

6/13

7" - 3272 RUST.

6/19

Arb. 3272'

7" - 3272'

T.D. 3286'

1000 acid.

Depthograph potential 32,813 bbl

Maximum 3000 bbls.

COMPLETED

Form 26—200 Bks.—1-40—Palace Ellsworth **KANSAS**

Map No. 55 Sec. 2 Twp. 17 R. 10W

Well No. 1 Stratmann "B"

Pryor & Lockhart Company

Contractor

# FIRST REPORT

C N L NE NE


330 Ft. from N. Line

         Ft. from S. Line

660 Ft. from E. Line

         Ft. from W. Line

## SECTION PLAT

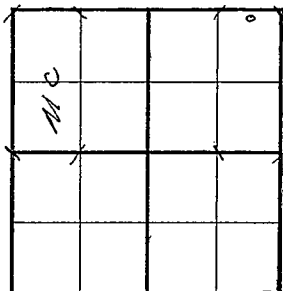

## STRATMANN POOL

Location X

Rig up         

Drilling and Remarks:

## RECORD

Cased          in.,          ft.

Sand         

Gas         

Oil         

Total Depth         

## PRODUCTION

1st 24 hrs. Nat.         

1st 24 hrs. after shot         

Gas          Cu. Ft.

Dry Hole         

Abandoned         

Date

MAY 22 1940

S. J. LEWIS Scout

Map No. 55 Sec. 2 Twp. 17 R. 10WWell No. 2 StratmanPryor & Lockhart CompanyCORRECTION Contractor

## SECTION PLAT

|  |  |  |    |
|--|--|--|----|
|  |  |  | 10 |
|  |  |  |    |
|  |  |  |    |
|  |  |  |    |

C N L NE NE

330 Ft. from N. Line         Ft. from S. Line660 Ft. from E. Line         Ft. from W. LineLocation                         Rig up                         

Drilling and Remarks:

Reported as  
#1 Stratman "B"

## RECORD

Cased          in.,          ft.Sand                         Gas                         Oil                         Total Depth                         

## PRODUCTION

1st 24 hrs. Nat.                         1st 24 hrs. after shot                         Gas                          Cu. Ft.Dry Hole                         Abandoned                         

Date

JUN 5 1940 19

S. J. LEWIS Scout

Form 26—200 Bks.—1-40—Palace Ellsworth **KANSAS**

Map No. 55 Sec. 2 Twp. 17 R. 10W

Well No. 2 Stratmann

Pryor & Lockhart Company

Contractor

**COMPLETE**

C N L NE NE

330 Ft. from N. Line

         Ft. from S. Line

660 Ft. from E. Line

         Ft. from W. Line

Stratmann Pool

**SECTION PLAT**

|  |  |  |   |
|--|--|--|---|
|  |  |  | e |
|  |  |  |   |
|  |  |  |   |
|  |  |  |   |

Location                     

Rig up                     

Drilling and Remarks:

*cu 83272*

*7" @ 3272*

*1000 acid*

*Depthograph R & 32803*

*Max 3000*

**RECORD**

Cased            in.,            ft.

Sand                     

Gas                     

Oil                     

Total Depth 3286

**PRODUCTION**

1st 24 hrs. Nat.                     

1st 24 hrs. after shot                     

Gas                      Cu. Ft.

Dry Hole                     

Abandoned                     

Date

JUN 19 1940 19

S. J. LEWIS Scout