

KANSAS


Form 51-5M-7-39-Palace

Ellsworth County, Kansas
Stratmann Pool

Section 2 Township 17 Range 10W

Well No. #3 Stratmann

Company Pryor & Lockhart

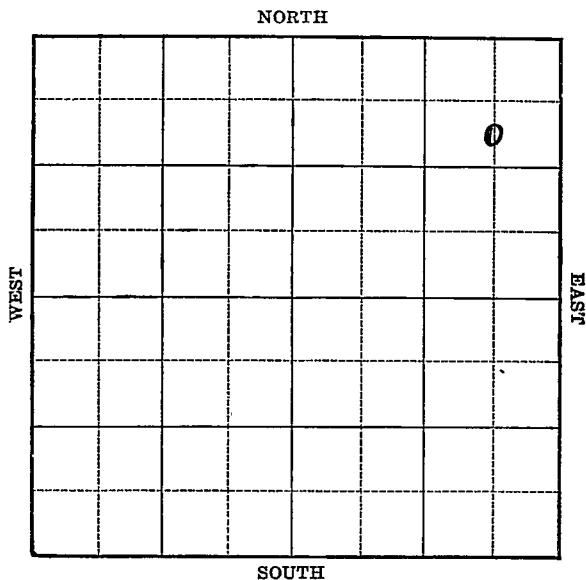

Sec. 2 Twp. 17 R. 10-W

Well No. #3 Stratmann Farm

Pryor & Lockhart Company
(Stratmann) NORTH


990 Ft. from N. Line

Ft. from S. Line

66.0 Ft. from E. Line

Ft. from W. Line

Elev. 1833

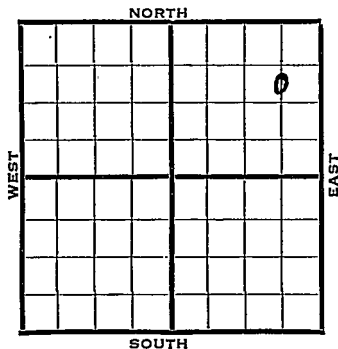[illegible]

Map No. 55 Sec. 2 Twp. 17 R. 10WWell No. 3 StratmannPryor & Lockhart

Company

Contractor

FIRST REPORT

SECTION PLAT

C S L NE NE

990 Ft. from N. Line Ft. from S. Line660 Ft. from E. Line Ft. from W. Line

STRATMANN POOL

			o

Location XRig up Drilling and Remarks:

RECORD

Cased in., ft.Sand Gas Oil Total Depth

PRODUCTION

1st 24 hrs. Nat. 1st 24 hrs. after shot Gas Cu. Ft.Dry Hole Abandoned

Date

JUN 26 1940₁₉S. J. LEWIS Scout

Map No. _____ Sec. 2 Twp. 17 R. 10WWell No. 3 StratmannPryor & Lockhart Company

Contractor

COMPLETED

C S L NE NE

990 Ft. from N. Line

_____ Ft. from S. Line

660 Ft. from E. Line

_____ Ft. from W. Line

ST RATMANN POOL

SECTION PLAT

			o

Location _____

Rig up _____

Drilling and Remarks:

*Cr 83274**7" @ 3273**1000 acid**Depthograph**6538**Mar 3000*

RECORD

Cased _____ in., _____ ft.

Sand _____

Gas _____

Oil _____

Total Depth 3295

PRODUCTION

1st 24 hrs. Nat. _____

1st 24 hrs. after shot _____

Gas _____ Cu. Ft.

Dry Hole _____

Abandoned _____

Date

JUL 24 1940 19S. J. LEWIS Scout