

KANSAS

Ellsworth

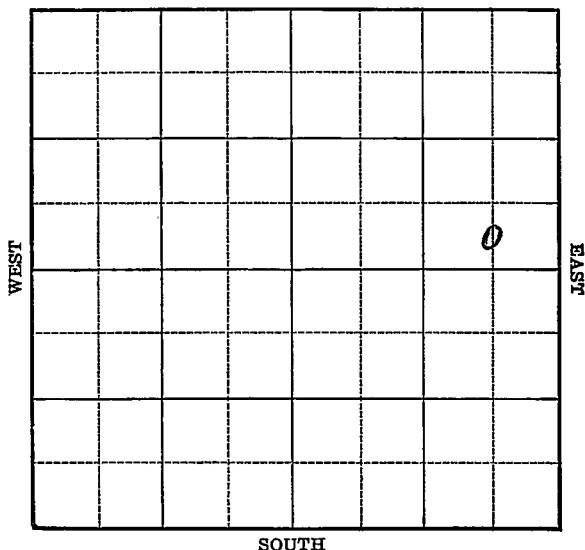
Form 51—5M—7-40—Palace

Section 2 Township 17 Range 10-W

Well No. #5 Stratmann

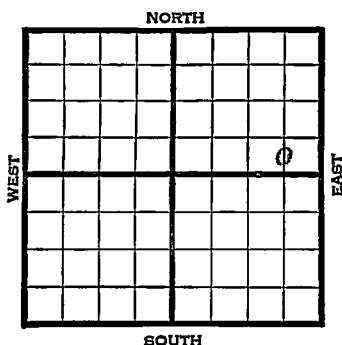
Company Pryor & Lockhart

NORTH Stratmann Pool



KANSAS

Ellsworth

Sec. 2 Twp. 17 R. 10-WWell No. #5 Stratmann FarmPryor & Lockhart Company
(Stratmann) Ft. from N. Line330 Ft. from S. Line660 Ft. from E. Line Ft. from W. Line

Elev. 1824

1940	REPORT
8/21	Derrick.
8/29	10" - 242' Drlg. 2050'
9/5	Lansing 2950' Cong. 3266'
	Arb. 3280-83' T.D. S.O.
	7" - 3281' RUST.
9/12	T.D. 3299' Bail 8 gals. oil
	per hour.
9/19	Shot 40 qts. 3286½-94' C.O.
9/26	Run liner.
10/3	100' 5" liner at 3286' WOC.
10/10	T.D. 3299' SSO. C.O.
10/17	" " " "
10/23	Arb. 3280'
	7" - 3281'
	T.D. 3299'
	40 qts. 3286½-94'
	1000 aci d.
	Potential 51 bbls., pump.
	COMPLETED

Map No. _____ Sec. 2 Twp. 17 R. 10WWell No. 5 Stratmann

Pryor & Lockhart _____ Company

Contractor

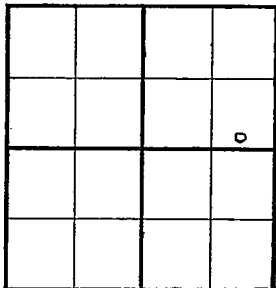
FIRST REPORT
C S L SE NE

_____ Ft. from N. Line

330 Ft. from S. Line660 Ft. from E. Line

_____ Ft. from W. Line

STRATMANN POOL

SECTION PLAT

Location _____

Rig up _____

Drilling and Remarks:

Derrick

RECORD

Cased _____ in., _____ ft.

Sand _____

Gas _____

Oil _____

Total Depth _____

PRODUCTION

1st 24 hrs. Nat. _____

1st 24 hrs. after shot _____

Gas _____ Cu. Ft.

Dry Hole _____

Abandoned _____

Date

AUG 21 1940 19

S. J. LEWIS Scout

Map No. 55 Sec. 2 Twp. 17 R. 10WWell No. 5 StratmannPryor & Lockhart

Company

Contractor

COMPLETED

C S L SE NE

SECTION PLAT

			6

 Ft. from N. Line330 Ft. from S. Line660 Ft. from E. Line Ft. from W. Line

STRATMANN POOL

Location Rig up

Drilling and Remarks:

*Per 2280**7" 2281**409 to 2286 1/2 - 84**1000 acid**Pump 51 28***RECORD**Cased in., ft.Sand Gas Oil Total Depth 2299**PRODUCTION**1st 24 hrs. Nat. 1st 24 hrs. after shot Gas Cu. Ft.Dry Hole Abandoned

Date

OCT 23 1940 19 S. J LEWIS Scout