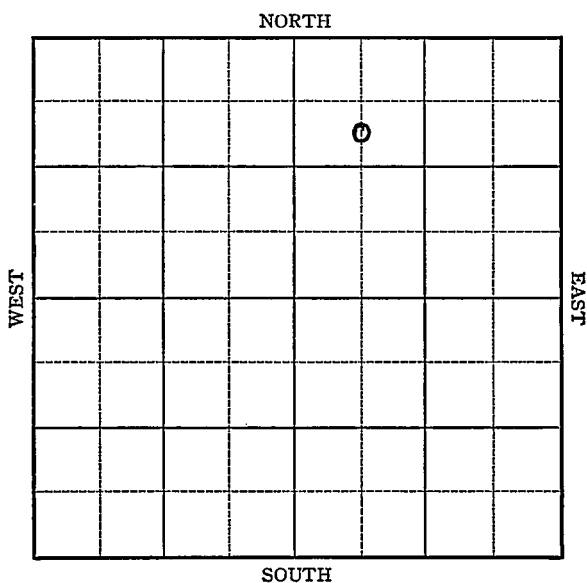


KANSAS

Section 2 Township 17 Range 10WWell No. 8 StratmanCompany Pryor & Lockhart et al

KANSAS


Ellsworth

Sec. 2 Twp. 17 R. 10-WWell No. #8 Stratman FarmPryor & Lockhart et al Company

(Stoltenberg)

990 Ft. from N. Line Ft. from S. Line Ft. from E. Line66.0 Ft. from W. Line

Elev. 1826

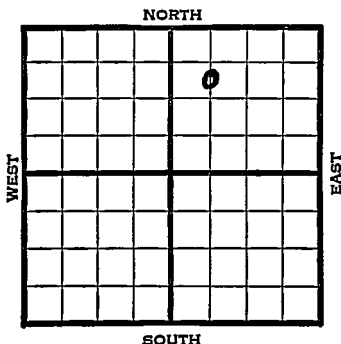

194

REPORT

6/11

Location

6/19

10" - 243' Anhy 543'

Drlg. 1250'

6/26

Drlg. 3075'

7/3

Arb. 3279-81' T.D. 7" - 3281'

RUST.

7/10

T.D. 3309' Swab 8 oil per hour.

7/16

Arb. 3279'

7" - 3281'

T.D. 3309'

Potential 217 bbls., pump.

44. Gravity

COMPLETED

Map No. 55 Sec. 2 Twp. 17 R. 10WWell No. 8 StratmanPryor & Lockhart etal Company

Contractor

FIRST REPORT

C S L NW NE

990 Ft. from N. Line Ft. from S. Line Ft. from E. Line660 Ft. from W. Line**SECTION PLAT**

		o	

STOLTENBERG POOLLocation XRig up

Drilling and Remarks:

RECORDCased in., ft.Sand Gas Oil Total Depth **PRODUCTION**1st 24 hrs.-Nat. 1st 24 hrs. after shot Gas Cu. Ft.Dry Hole Abandoned

Date

JUN 11 194119S. J. LEWIS Scout

Map No. 55 Sec. 2 Twp. 17 R. 10WWell No. 8 Stratmann

Pryor & Lockhart etal Company

COMPLETED

Contractor

SECTION PLATC S L NW NE
990 Ft. from N. Line Ft. from S. Line Ft. from E. Line660 Ft. from W. Line**STOLTENBERG POOL**

Location Rig up

Drilling and Remarks:

*Ac 43279**7" @ 3281**Pump 217 P.Y**44 - 9***RECORD**Cased in., ft.Sand Gas Oil Total Depth 3309**PRODUCTION**1st 24 hrs. Nat. 1st 24 hrs. after shot Gas Cu. Ft.Dry Hole Abandoned

Date

Jul 16 1941 19 S. I. LEWIS Scout