

KANSAS

Form 51—5M—7-40—Palace


Ellsworth

Section 2 Township 17 Range 10-W

Well No. #7 Stratmann

Company Pryor & Lockhart

NORTH Stratmann Pool

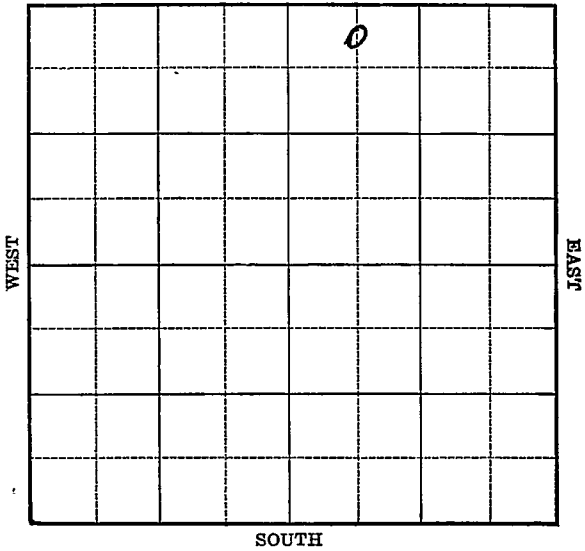

Sec. 2 Twp. 17 R. 10-W

Well No. #7 Stratmann Farm

Pryor & Lockhart Company

(Stratmann)


330 Ft. from N. Line

Ft. from S. Line

Ft. from E. Line

660 Ft. from W. Line

Elev. 1826

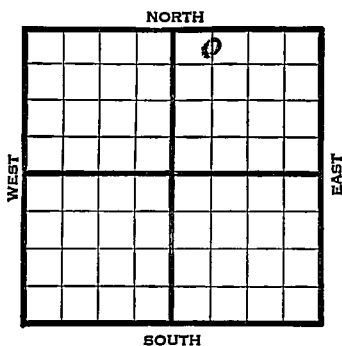

1940	REPORT
12/11	Derrick.
12/19	"
12/26	10" - 231' WOC.
1941	
1/2	Drilg. 2185'
1/9	Arb. 3269-71' T.D. Saturation.
	7" - 3269' RUST.
1/15	Arb. 3269'
	7" - 3269'
	T.D. 3278'
	1000 aci d.
	Depthograph potential 16,739 bbl
	Maximum 3000 bbls .
	44. Gravity
	COMPLETED

Map No. 55 Sec. 2 Twp. 17 R. 10WWell No. 7 Stratmann

Pryor & Lockhart

Company

Contractor

FIRST REPORT

SECTION PLAT

		0	

330 C N L NW NE
Ft. from N. Line

Ft. from S. Line

Ft. from E. Line

660 Ft. from W. Line

STRATMANN POOL

Location

Rig up

Drilling and Remarks:

Derrick

RECORD

Cased _____ in., _____ ft.

Sand _____

Gas _____

Oil _____

Total Depth _____

PRODUCTION

1st 24 hrs. Nat. _____

1st 24 hrs. after shot _____

Gas _____ Cu. Ft.

Dry Hole _____

Abandoned _____

Date

DEC 11 1940

S. J. LEWIS Scout

Map No. 55 Sec. 2 Twp. 17 R. 10WWell No. 7 StratmannPryor & Lockhart Company

Contractor

COMPLETED

C N L NW NE

330 Ft. from N. Line Ft. from S. Line Ft. from E. Line660 Ft. from W. Line**SECTION PLAT**

		0	

STRATMANN POOLLocation Rig up

Drilling and Remarks:

*Cu x 3269**7" @ 3269**1400 acid**Sept 8 16739**Max 3000**44° Gr.***RECORD**Cased in., ft.Sand Gas Oil Total Depth 3279**PRODUCTION**1st 24 hrs. Nat. 1st 24 hrs. after shot Gas Cu. Ft.Dry Hole Abandoned

Date

JAN 15 1941 19S. J. LEWIS Scout