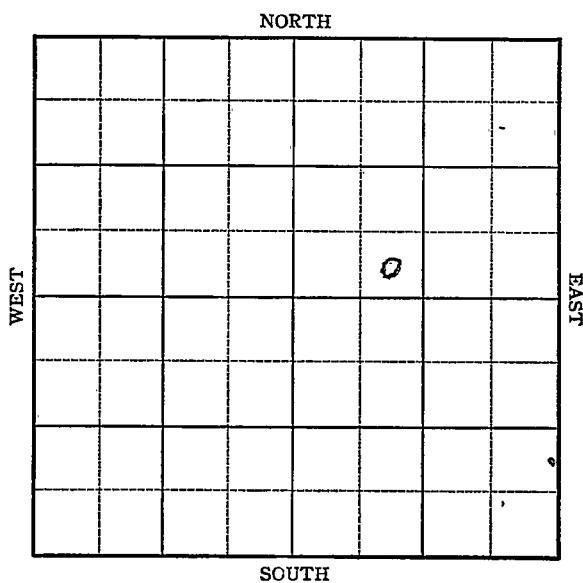


KANSAS

Ellsworth

Section 2 Township 17 Range 10-WWell No. #10 StratmannCompany NCRA

KANSAS

Ellsworth County


Sec. 2 Twp. 17 R. 10WWell No. #10 Stratmann FarmN C R A

Company

Stoltenberg

 Ft. from N. Line330 Ft. from S. Line Ft. from E. Line990 Ft. from W. Line

SE SW NE

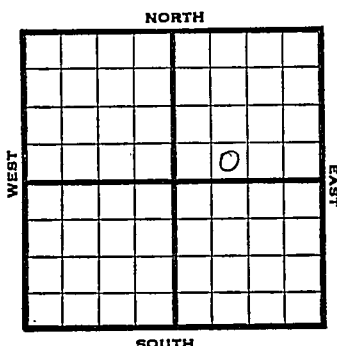

1946

Elev. 1823'

REPORT

1/16

Location

1/24 8" - 261' WOC.

1/31 Drlg. 2828'

2/7 Lans. 2955' Arb. 3271-76' T.D. S.O.

5" - 3273' RUST.

2/14 T.D. 3298' 600' oil 12 hours.

2/21 " " "

2/28 " " "

3/6

Arb. 3271

5" @ 3273

TD 3298

Pump 80 Pot.

Grav. 4210

COMPLETED

Pool Name Stöltenberg**KANSAS**

Kansas

Map No. 55 Sec. 2 Twp. 17 R. 10WWell No. 10 StratmannN C R A

Company

FIRST REPORT

Contractor

SE SW NE**SECTION PLAT**

Ft. from N. Line

330 Ft. from S. Line

Ft. from E. Line

990 Ft. from W. LineEllsworth CountyLocation X

Rig up

Drilling and Remarks:

RECORD

Cased _____ in., _____ ft.

Sand _____

Gas _____

Oil _____

Total Depth _____

PRODUCTION

1st 24 hrs. Nat. _____

1st 24 hrs. after shot _____

Gas _____ Cu. Ft.

Dry Hole _____

Abandoned _____

Date

JAN 16 1946

19

S. J. LEWIS

Scout

KANSAS Kansas Pool Name Stoltenberg
 Map No. 53 Sec. 2 Twp. 17 R. 10W
 Well No. 10 Stratmann


N C R A

Company

COMPLETED

Contractor

SE SW NE

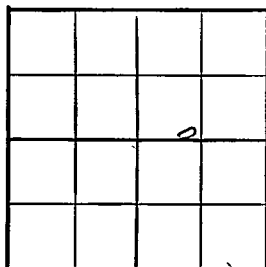E11823
 SECTION PLAT


Ft. from N. Line

330 Ft. from S. Line

Ft. from E. Line

990 Ft. from W. Line

Ellsworth County

Location

Rig up

Drilling and Remarks:

CE 32215' CE 3223Pump 50 ft42 e.g.

RECORD

Cased _____ in., _____ ft.

Sand _____

Gas _____

Oil _____

Total Depth 1298'

PRODUCTION

1st 24 hrs. Nat. _____

1st 24 hrs. after shot _____

Gas _____ Cu. Ft.

Dry Hole _____

Abandoned _____

Date

MAR 6 1946 19S. J. LEWIS Scout