


Section 20 Township 17 Range 10W

Well No. #1 J. Secret

Company Imperial Pet.

NORTH

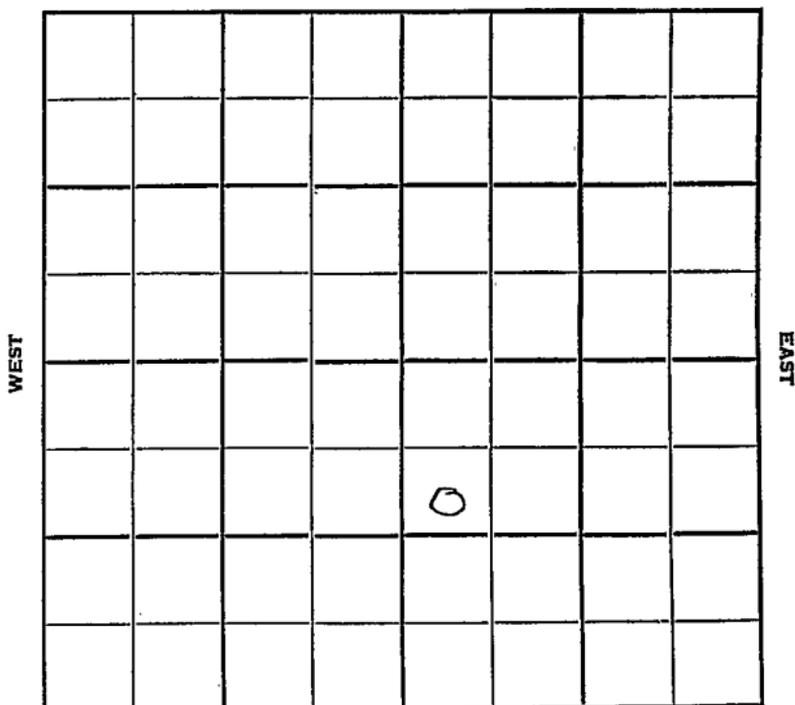

SOUTH

Sec. 20 Twp. 17 R. 10W ✓

Well No. #1 J. Secrest Farm

Imperial Pet. Company

Imperial - Contr. Contractor

Bloomer


990' Ft. from N. Line

..... Ft. from S. Line

..... Ft. from E. Line

330' Ft. from W. Line

SW NW SE

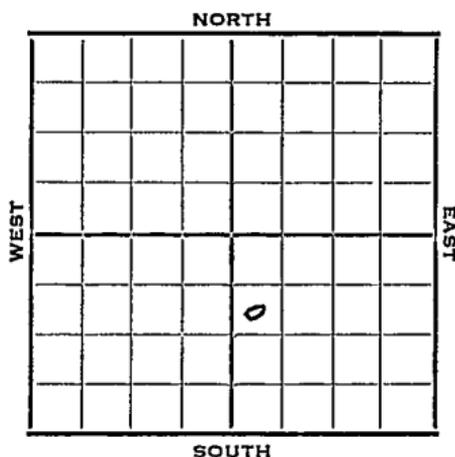

1952	Elev. 1821' REPORT
2/27	Spud 2-22-52 8" @ 224 Anhy 580-610 Drlg. 1880'
3/5	Lans. 2975' DST 3017-37, 1 hr, 12' GCM Arb. 3290' DST 3283-97', 1 hr, 5' M NS RTD 3297' 5" @ 3290'
3/11	MICT
3/19	Spud 2-22-52 D&A TD 3325 8" @ 224 Anhy 580-610 Lans. 2975 DST 3017-37 opn 1 hr. Rec. 12' gcm Arb. 3290 DST 3283-97 opn 1 hr Rec 5' mud TD 3297 5" @ 3290 Heeb. 2852 Br Lime 2955 Cong. 3248 ReArb. 3283 DD 3320 S/1 bwph 4 hr. S/4½ bwph 2 hr. DD 3325 D&A
	<b>ABANDONED</b>



