

KANSAS Ellsworth

Sec. 20 Twp. 17 R. 9-W

Well No. #1 Kruse Farm

Cities-Service Oil Company

(Schroeder)


 Ft. from N. Line

440 Ft. from S. Line

 Ft. from E. Line

440 Ft. from W. Line

Elev. 1768

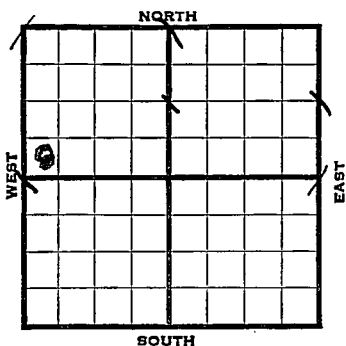

1938	REPORT
12/21	Location
12/30	10" - 221'. Drlg. 646'.
1939	
1/6	Drlg. 2585'.
1/11	Arb. 3235'.
	T. D. 3256'.
	800' water in 30 min. by drill stem test.
	ABANDONED

Map No. 45 Sec. 20 Twp. 17 R. 9W

Well No. 1 Kruse

Cities Service Oil Company

Contractor

FIRST REPORT

SW NW

 Ft. from N. Line


440 Ft. from S. Line

 Ft. from E. Line

440 Ft. from W. Line

SCHROEDER Pool

SECTION PLAT

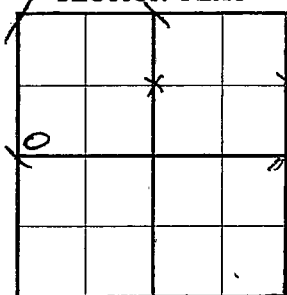

Location X

Rig up

Drilling and Remarks:

RECORD

Cased in., ft.

Sand

Gas

Oil

Total Depth

PRODUCTION

1st 24 hrs. Nat.

1st 24 hrs. after shot

Gas Cu. Ft.

Dry Hole

Abandoned

Date

DEC 21 1938 19

H. D. Hatfield Scout

Ellsworth KANSAS

Map No. 45 Sec. 20 Twp. 17 R. 9WWell No. 1 KruseCities Service Oil Company

Contractor

ABANDONED

SW NW

SECTION PLAT

0			

_____ Ft. from N. Line

440 Ft. from S. Line

_____ Ft. from E. Line

440 Ft. from W. Line

SCHROEDER POOL

Location _____

Rig up _____

Drilling and Remarks:

800' wtr in 30 min
by Drill Stem Test

D & A

RECORD

Cased _____ in., _____ ft.

Sand Arb 3235

Gas _____

Oil _____

Total Depth 3256

PRODUCTION

1st 24 hrs. Nat. _____

1st 24 hrs. after shot _____

Gas _____ Cu. Ft.

Dry Hole _____

Abandoned _____

Date

JAN 11 1938

19

H. D. Hatfield Scout