

KANSAS

Ellsworth


Form 51-5M-7-40-Palace

Section 20 Township 17 Range 9-W

Well No. #4 H. B. Schroeder

Company Gulf

NORTH Wilkins Pool

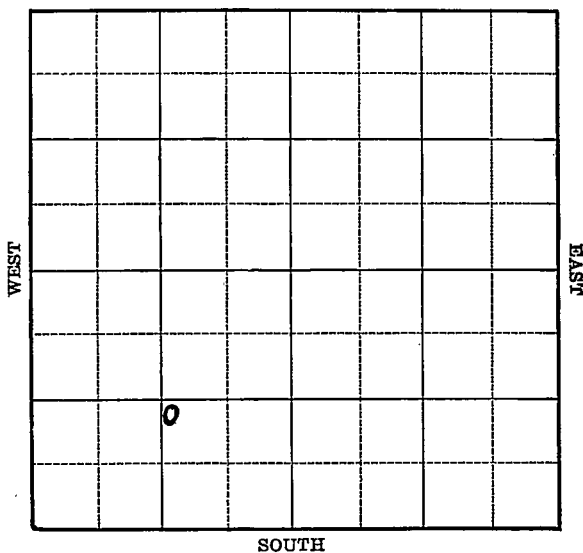

Map No. 45 Sec. 20 Twp. 17 R. 9WWell No. 4 H. B. SchroederGulf

Company

Contractor


FIRST REPORT

NW SE SW

 Ft. from N. Line1220 Ft. from S. Line Ft. from E. Line1350 Ft. from W. Line

WILKINS POOL

SECTION PLAT

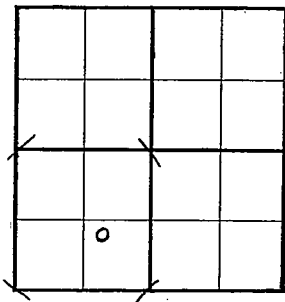Location Rig up

Drilling and Remarks:

8 5/8 - 200Anhy 430Drlg. 2844

RECORD

Cased in., ft.Sand Gas Oil Total Depth

PRODUCTION

1st 24 hrs. Nat. 1st 24 hrs. after shot Gas Cu. Ft.Dry Hole Abandoned

Date

JUL 31 1940 19S. J. LEWIS Scout

Map No. 45 Sec. 20 Twp. 17 R. 9WWell No. 4 H. B. Schroeder

Gulf

Company

Contractor

COMPLETED

NW SE SW

 Ft. from N. Line1220 Ft. from S. Line Ft. from E. Line1350 Ft. from W. Line

WILKINS POOL

SECTION PLAT

	0		

Location Rig up

Drilling and Remarks:

*Cr & 3220**5" @ 3221**Coriometel P & Y**10697**Map 3000*

RECORD

Cased in., ft.Sand Gas Oil Total Depth 3224

PRODUCTION

1st 24 hrs. Nat. 1st 24 hrs. after shot Gas Cu. Ft.Dry Hole Abandoned

Date

AUG 14 1940 19

S. J. LEWIS Scout