


Section 20 Township 17 Range 9-W

Well No. 1 H. Schroeder

Company Gulf

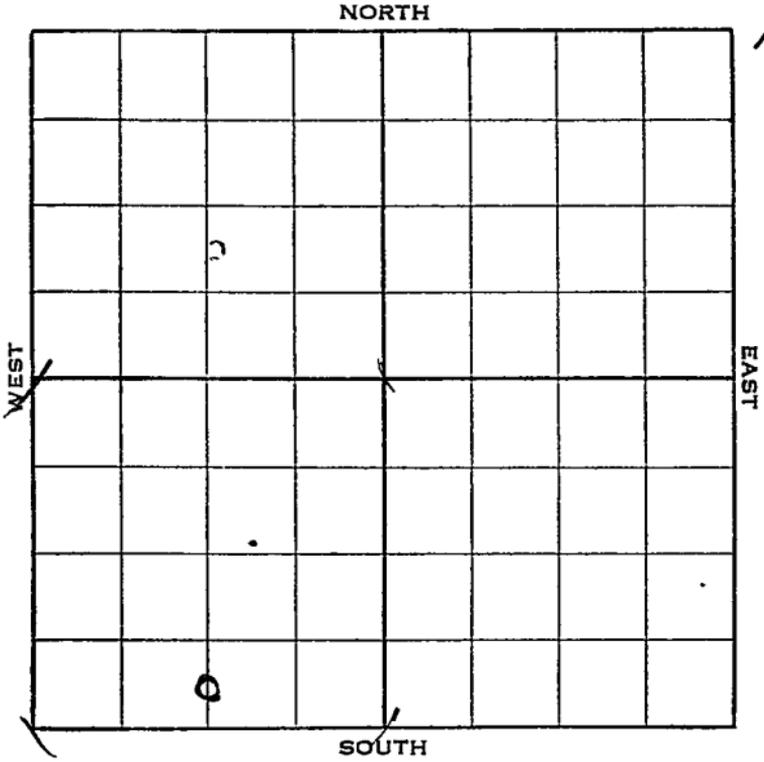

Sec. 20 Twp. 17 R. 9-W

Well No. #1 H. Schroeder Farm
Gulf Company


_____ Ft. from N. Line

440 Ft. from S. Line

_____ Ft. from E. Line

1320 Ft. from W. Line

Elev. 1761'

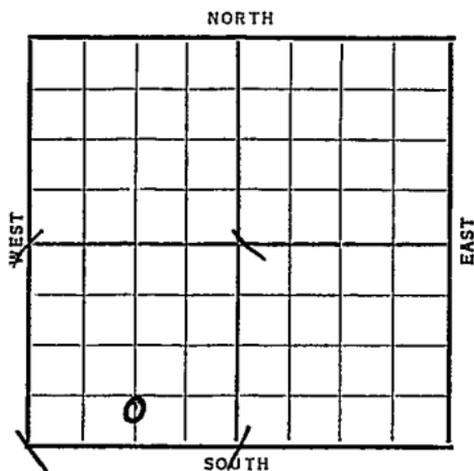


Date	REPORT
1938	
2/2	Location
2/11	S. H.
2/18	10" @ 180'. Drlg. 2640'.
2/26	Base K. C. 3174'.
	Simp. sand 3204'.
	S.O. 3210-13'.
	Arb. 3213'.
	S.O. 3213-16½ T.D.
	7" @ 3213'. RUST.
3/4	T.D. 3218'. 3100' oil.
	2000 acid.
3/9	7" @ 3213'.
	Arb. 3213'.
	T.D. 3218'.
	2000 acid.
	Potential 1614 bbls.
	COMPLETED

Map No. _____ Sec. 20 Twp. 17 R. 9WWell No. 1 H. SchroederGulf

Company

Contractor

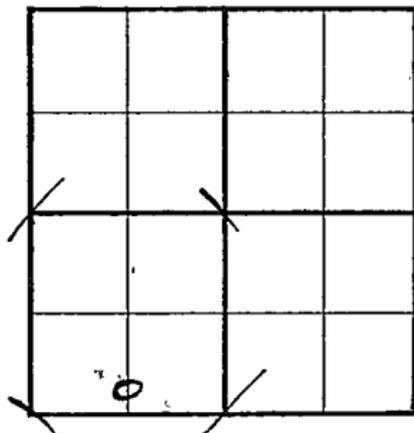FIRST REPORT**C S L SW****SECTION PLAT** Ft. from N. Line440 Ft. from S. Line Ft. from E. Line1320 Ft. from W. LineLocation X

Rig up _____

Drilling and Remarks:

RECORD

Cased _____ in., _____ ft.

Sand _____

Gas _____

Oil _____

Total Depth _____

PRODUCTION

1st 24 hrs. Nat. _____

1st 24 hrs. after shot _____

Gas _____ Cu. Ft.

Dry Hole _____

Abandoned _____

Date

FEB 2 1938 19H. D. Hatfield Scout

Map No. 45 Sec. 20 Twp. 17 R. 9W

Well No. 1 H. Schroeder

Gulf Company

Contractor

COMPLETED

C S L SW

 Ft. from N. Line

440 Ft. from S. Line

 Ft. from E. Line

1320 Ft. from W. Line

SECTION PLAT

⊙

Location

Rig up

Drilling and Remarks:

zoo acid
POT 1614

RECORD

Cased 7 in., 3213 ft.

Sand Arb 3213

Gas

Oil

Total Depth 5218

PRODUCTION

1st 24 hrs. Nat.

1st 24 hrs. after shot

Gas Cu. Ft.

Dry Hole

Abandoned

Date

MAR 9 - 1938

19

H. D. Hatfield Scout