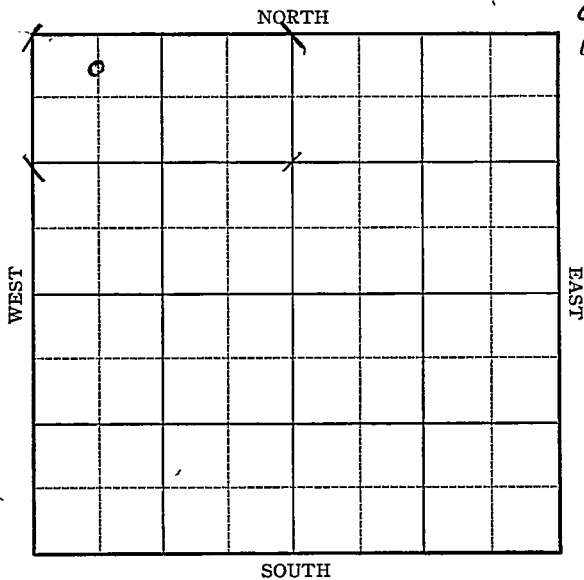


KANSAS

FORM 51 5M 1-42 PETROL

McPherson

Section 20 Township 17 Range 5-WWell No. #1 DouglasCompany J. J. Lynnn & Davis Child

KANSAS

McPherson

Sec. 20 Twp. 17 R. 5-W

Well No. #1 Douglas Farm

J. J. Lynn & Davis Child Company


Wildcat

330 Ft. from N. Line

 Ft. from S. Line

 Ft. from E. Line

660 Ft. from W. Line

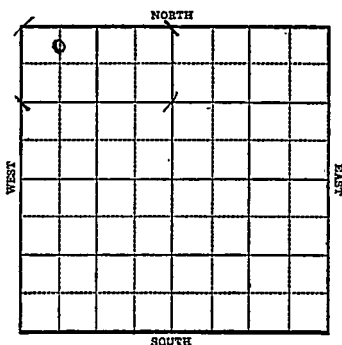

1943

R E P O R T

6/16 Derrick

6/23 12" @ 190'
Drlg. 600'

6/30 Drlg. 2520'

7/7 Topeka 2186
Lans 2628
Drlg. 3156'

7/14 Miss. 3198
Arb. 3760
T.D. 3787'
No shows.

ABANDONED

KANSAS
 Map No. 2 Sec. 20 Twp. 17 R. 5W

Well No. 1 Douglas


J. J. Lynn & Davis Child Company

FIRST REPORT

Contractor

C NL NW NW

SECTION PLAT

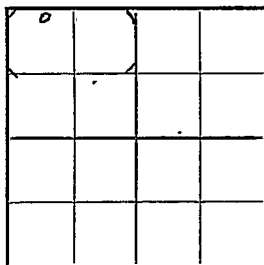

330 Ft. from N. Line

_____ Ft. from S. Line

_____ Ft. from E. Line

660 Ft. from W. Line

WILDCAT

Location _____

Rig up _____

Drilling and Remarks:

Derrick

RECORD

Cased _____ in., _____ ft.

Sand _____

Gas _____

Oil _____

Total Depth _____

PRODUCTION

1st 24 hrs. Nat. _____

1st 24 hrs. after shot _____

Gas _____ Cu. Ft.

Dry Hole _____

Abandoned _____

Date

JUN 16 1943 19

S. J. LEWIS Scout

KANSAS

McPherson

Map No. 44 Sec. 20 Twp. 17 R. 5WWell No. 1 DouglasJ. J. Lynn & Davis Child Company

ABANDONED

Contractor

C NL NW NW

SECTION PLAT

0			

330 Ft. from N. Line Ft. from S. Line Ft. from E. Line660 Ft. from W. Line

WILD CAT

Location Rig up

Drilling and Remarks:

*Miles 3198**Cr 43760**No show*

RECORD

Cased in., ft.Sand Gas Oil Total Depth 3282

PRODUCTION

1st 24 hrs. Nat. 1st 24 hrs. after shot Gas Cu. Ft.Dry Hole Abandoned

Date

JUL 14 1943 19S. J. LEWIS Scout