FORM 51 5M 11-44 PETROL


KANSAS

McPherson

Section 20 Township 17 Range 3W

Well No. #1 Swenson

Company Galva Oil & Gas Ind.

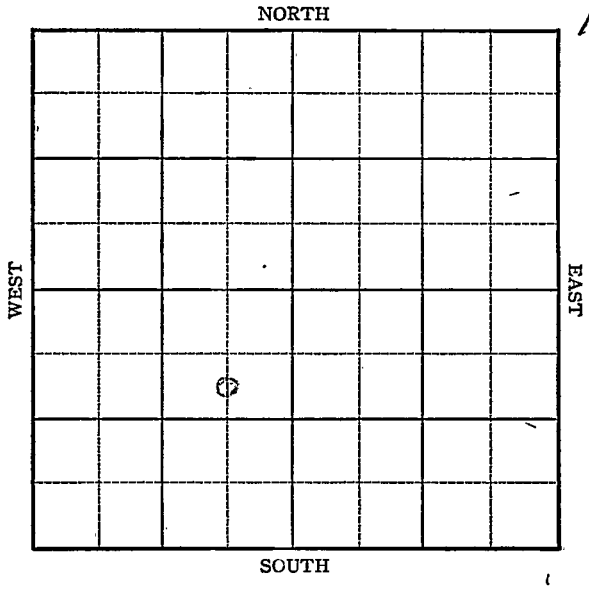

FORM 252-A
5M 9-44 PETROL

KANSAS

McPherson

Sec. 20 Twp. 17 R. 3W

Well No. #1 Swenson Farm

Galva Oil & Gas Ind. Company


Lindsborg

990 Ft. from N. Line

Ft. from S. Line

660 Ft. from E. Line

Ft. from W. Line

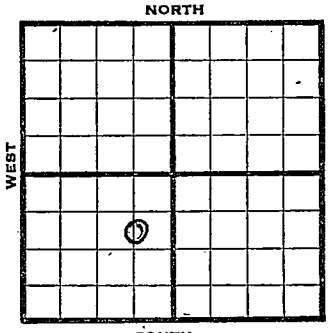

CSL NE SW Elev. 1327

1945	REPORT
3/7	15 - 150 10" - 354 Miss 2905 Drlg 3150
3/14	Tight hole
3/21	Kind 3135 Viola 3404 Simp sd 3512 Arb 3558 TD 3600'

ABANDONED

FORM 26 200 BKS 1-44 PETROL

Pool Name Lindsborg

Map No. 42 Sec. 20 Twp. 17 R. 3W

Well No. 1 Swendon

Galva Oil & Gas Ind. Company

FIRST REPORT Contractor

C S L NE SW


990 Ft. from N. Line

Ft. from S. Line

660 Ft. from E. Line

Ft. from W. Line

SECTION PLAT

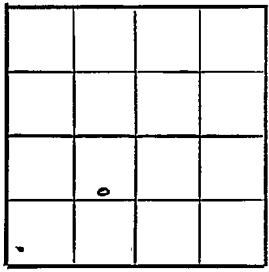

McPherson

Location

Rig up

Drilling and Remarks:

15-150

10"-354

Miss 2905

3150

RECORD

Cased in., ft.

Sand

Gas

Oil

Total Depth

PRODUCTION

1st 24 hrs. Nat.

1st 24 hrs. after shot

Gas Cu. Ft.

Dry Hole

Abandoned

Date

MAR 7 1945 19 S. J. LEWIS Scout

FORM 26 200 BKS. 2-44 PETROL

Pool Name Lindsborg

Map No. 4/2 Sec. 20 Twp. 17 R. 3W

Well No. 1 Swenson

Galva Oil & Gas Ind. Company

ABANDONED Contractor

C S L NE SW


990 Ft. from N. Line

Ft. from S. Line

660 Ft. from E. Line

Ft. from W. Line

SECTION PLAT

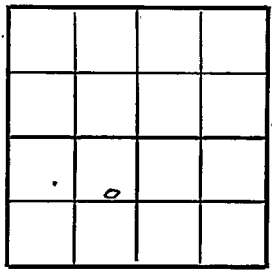

McPherson County

Location

Rig up

Drilling and Remarks:

Kind 8135
Vista 3404
Emp Bol 3512
Ell 3558

RECORD

Cased in., ft.

Sand

Gas

Oil

Total Depth 3660

PRODUCTION

1st 24 hrs. Nat.

1st 24 hrs. after shot

Gas Cu. Ft.

Dry Hole

Abandoned

Date

MAR 2 1 1945 19

S. J. LEWIS Scout