


Section 20 Township 17 Range 3W

Well No. #1 Thompson

Company Joe Morine etal.
Lindsborg Pool

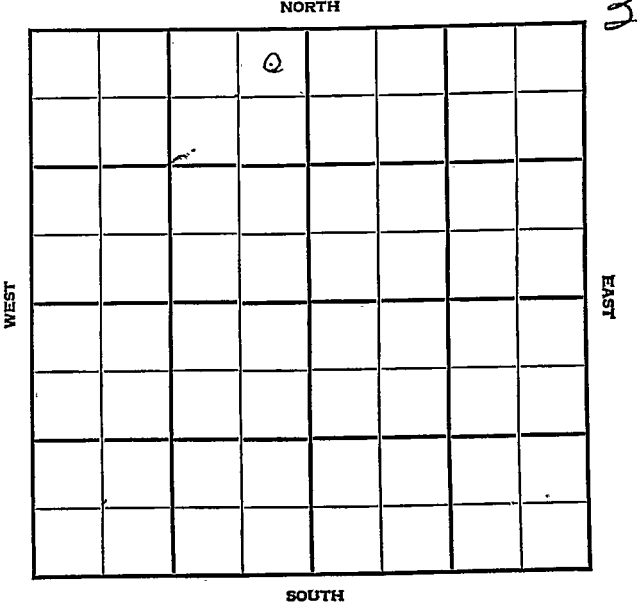



Sec. 20 Twp. 17 R. 3W

Well No. #1 Thompson Farm

Joe Morine et al Company

Lindsborg


330' Ft. from N. Line

_____ Ft. from S. Line

330' Ft. from E. Line

_____ Ft. from W. Line

NE NW

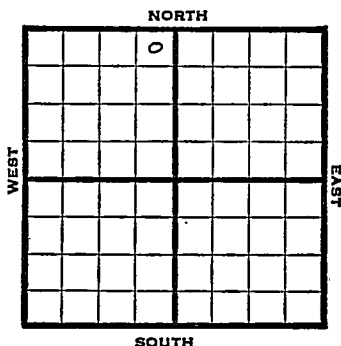

1948	Elev. 1336' REPORT
3/24	12" @ 160' 8" @ 360' WOC
3/31	Mississippi 2898' Drlg. 3085'
4/7	Viola 3387' Simp. Sd 3479' TD 3495'
ABANDONED	

Map No. _____ Sec. 20 Twp. 17 R. 3W

Well No. 1 Thompson

Joe Morine etal. Company

FIRST REPORT

Contractor

NE NW

SECTION PLAT

330 Ft. from N. Line

_____ Ft. from S. Line

330 Ft. from E. Line

_____ Ft. from W. Line

McPherson County

Location _____

Rig up _____

Drilling and Remarks:

12" @ 160

8" @ 360 WOC

RECORD

Cased _____ in., _____ ft.

Sand _____

Gas _____

Oil _____

Total Depth _____

PRODUCTION

1st 24 hrs. Nat. _____

1st 24 hrs. after shot _____

Gas _____ Cu. Ft.

Dry Hole _____

Abandoned _____

Date

MAR 24 1948 19

S. J. LEWIS Scout

Map No. 42 Sec. 20 Twp. 17 R. 3W

Well No. 1 Thompson

Joe Morine etal. Company

ABANDONED

Contractor

NE NW

E/1236
SECTION PLAT

330 Ft. from N. Line

_____ Ft. from S. Line

330 Ft. from E. Line

_____ Ft. from W. Line

	4		

McPherson County

Location _____

Rig up _____

Drilling and Remarks:

Water 3387
Briny Sol 3479

RECORD

Cased _____ in., _____ ft.

Sand _____

Gas _____

Oil _____

Total Depth 3495

PRODUCTION

1st 24 hrs. Nat. _____

1st 24 hrs. after shot _____

Gas _____ Cu. Ft.

Dry Hole _____

Abandoned _____

Date

APR 7 1948 19 S. J. LEWIS Scout