
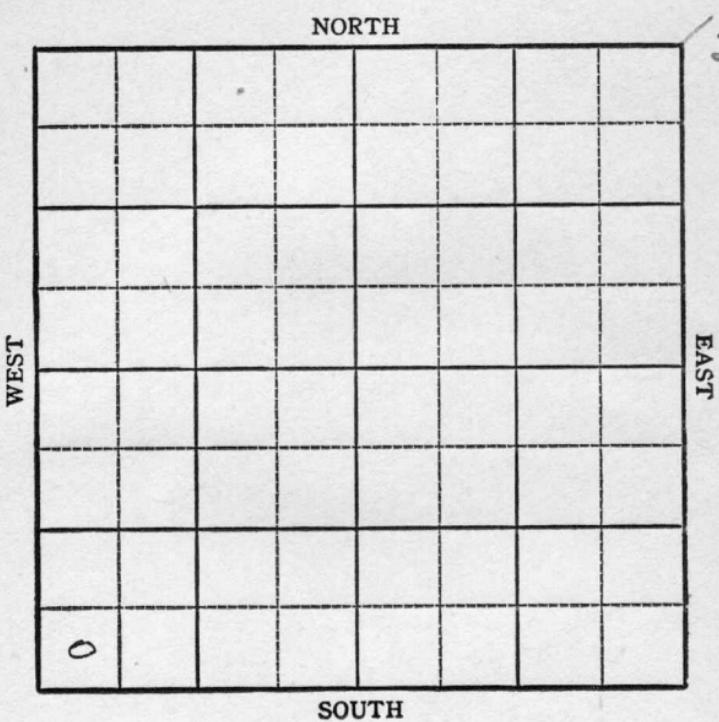


Section 20 Township 17 Range 7WWell No. #1 CampbellCompany Elwell et al

Ellsworth

Form 252-A
5M 4-32 MPC

Map No. KANSAS Sec. 20 Twp. 17 R. 7^W
Well No. 1 Campbell Farm
Elwell et al Company

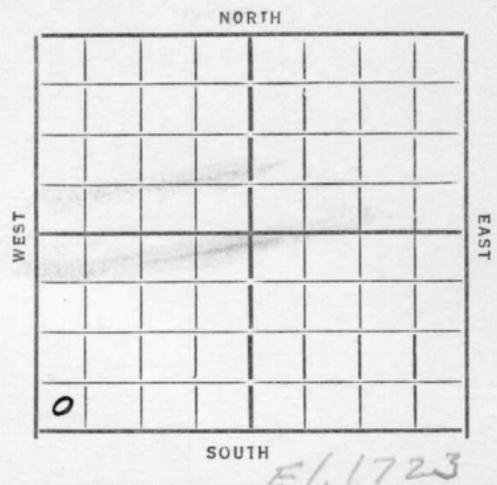

____ Ft. from N. Line

330 Ft. from S. Line

____ Ft. from E. Line

330 Ft. from W. Line

REPORT

Date 1954

Location

<u>6/27</u>	
<u>7/5</u>	—
<u>7/12</u>	<u>Cellar</u>
<u>7/19</u>	<u>B. R.</u>
<u>7/26</u>	<u>Rig</u>
<u>8/2</u>	<u>Dly 325</u>
<u>8/9</u>	<u>Run 12" 1120</u>
<u>8/16</u>	<u>Dly 1950</u>
<u>8/23</u>	<u>" 3305 10" 2211</u>
<u>8/30</u>	<u>4792 2705-15 8" 2732</u>
	<u>TC. L. 2785</u>
<u>9/6</u>	<u>3075 C.O.</u>
<u>9/13</u>	<u>6" 3058 S.O. 3160 7sg 3880</u>
<u>9/20</u>	<u>Siliceous 3475 ? TD 3480</u>
<u>9/26</u>	<u>Siliceous 3475 TD 3511 117</u>

ABANDONED

Ellsworth

Map No. 45 Sec. 20 Twp. 17 R. 7W

Well No. 1 Campbell


Elwell et al

Company

Contractor

ABANDONED

SECTION PLAT

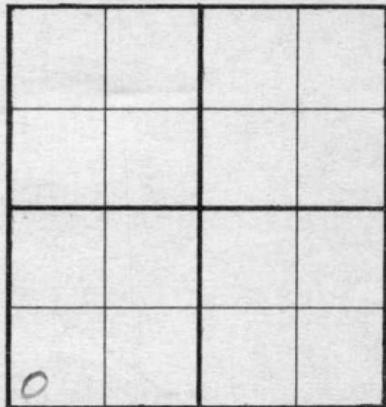

Ft. from N. Line

330 Ft. from S. Line

Ft. from E. Line

330 Ft. from W. Line

Location _____

RECORD

Cased in., ft.

Sand *silicous 3475*

Gas _____

Oil _____

Total Depth *3511*

PRODUCTION

1st 24 hrs. Nat. _____

1st 24 hrs. after shot _____

Gas Cu. Ft. _____

Dry Hole _____

Abandoned _____

Date

9/26/34


19

C. Marmachuk Scout

Map No. 45 Sec. 20 Twp. 17 R. 7^WWell No. 1-CampbellElwellFIRST REPORTS

Company

Contractor

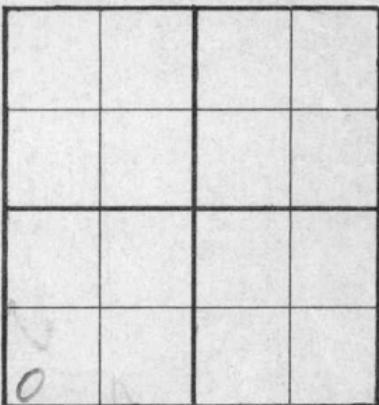SECTION PLAT

Ft. from N. Line

330

Ft. from S. Line

Ft. from E. Line

330

Ft. from W. Line

Location ✓

Rig up

Drilling and Remarks:

RECORD

Cased _____ in., _____ ft.

Sand _____

Gas _____

Oil _____

Total Depth _____

PRODUCTION

1st 24 hrs. Nat. _____

1st 24 hrs. after shot _____

Gas _____ Cu. Ft.

Dry Hole _____

Abandoned _____

Date

6-27-34 19

ORVAL MANNSCHRECK

Scout

LEASE PURCHASE AGREEMENT

Ellsworth County,

Kansas.

Location of Well: SW cor of SW $\frac{1}{4}$ Sec 20 or
NE cor of NE $\frac{1}{4}$ Sec 20, 17S-7W

To Whom: H.V. Elwell, 309 Ellis-Singleton Bldg, Wichita, Kans.

Amount \$3200.00 on completion of well

Commence by: Aug 6, 1934 Complete by Jan 1, 1935; Siliceous Lime

Remarks: We are purchasing for the above sum, subject to
payment on completion of above well the W $\frac{1}{2}$ of NW $\frac{1}{4}$ of Sec 20, and
N $\frac{1}{2}$ of SE $\frac{1}{4}$ of Sec 30, 17S-7W.

We are to be furnished a complete set of samples etc from the well
as well as weekly reports of drilling operations and on completion
a complete log of the well.

REPORTS ON WELL

+

INTER-OFFICE MEMO

Mid-Continent Petroleum Corporation

Date September 24th, 1934.

From Orval Mannschreck

11434-35

To Frank Bowling

Subject

11434-Sarah Miller.

Dear Sir:-

Enclosed find letter, from Mr. Elwell's office, advising that purchase price of above lease should be paid to the Lario Oil & Gas Company. I have, therefore, mailed the \$1600.00 check to them.

Our purchase agreement, covering the W/2 NW/4 of 20 and N SE/4 of 30-17-7W, has been completed and the purchase price is now due and payable. The well in the SW/4 corner of 20-17-7W having been drilled to a total depth of 3511 feet. Siliceous Lime topped at 3475 feet. The test has been approved by all companies buying acreage on same.

Yours very truly,

