


KANSAS Ellsworth County

Section 21 Township 17 Range 10W

Well No. #1 Schepmann

Company Phillips

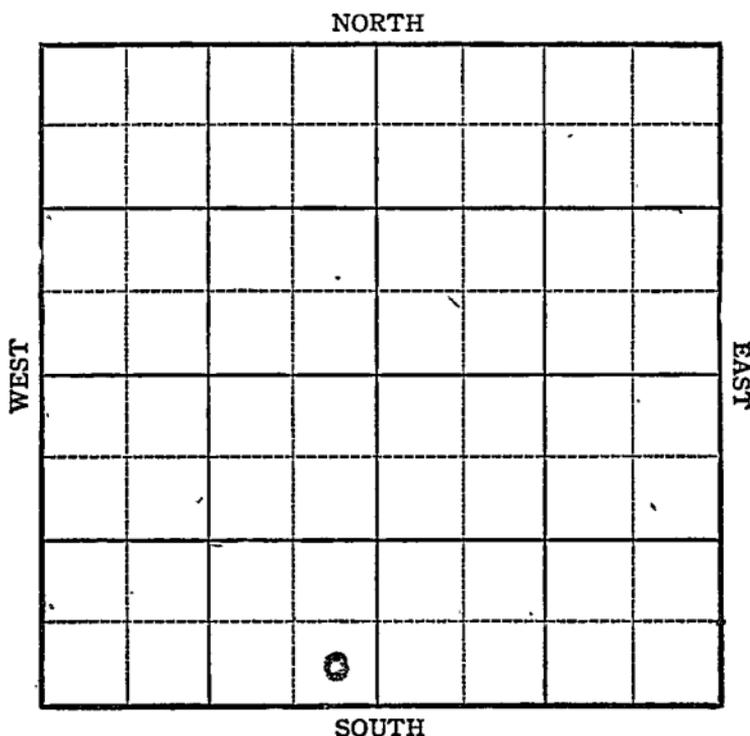

KANSAS

Sec. 21 Twp. 17S R. 10W

Well No. #1, Schepmann Farm _____

Phillips Company

Stoltenberg

_____ Ft. from N. Line

330

_____ Ft. from S. Line


330

_____ Ft. from E. Line

_____ Ft. from W. Line

SE SW

Elev. 1829

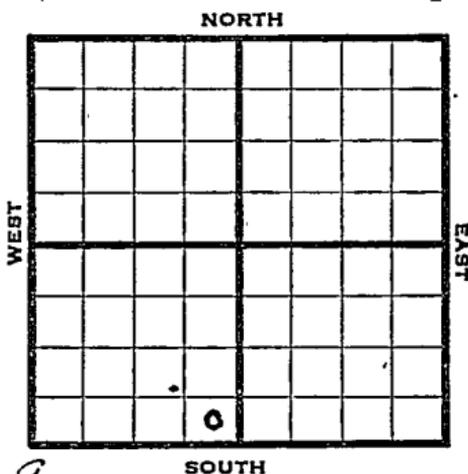

R E P O R T

1945

1-3 Location

1/10 8" @ 507
Drlg 1890

1/17 Heebner 2852
Lans 2992
Drlg 3150

1/24 Cong. 3278
Arb. 3315
TD 3350


ABANDONED

Pool Name StoltenbergMap No. 55 Sec. 21 Twp. 17 R. 10WWell No. 1 SchepmannPhillips Company

FIRST REPORT Contractor

SE SW

SECTION PLAT

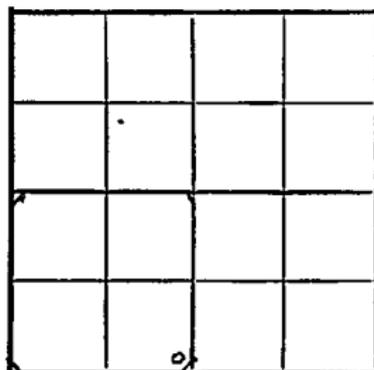 Ft. from N. Line330 Ft. from S. Line330 Ft. from E. Line Ft. from W. Line

Ellsworth

Location XRig up

Drilling and Remarks:

RECORD

Cased in., ft.Sand Gas Oil Total Depth

PRODUCTION

1st 24 hrs. Nat. 1st 24 hrs. after shot Gas Cu. Ft.Dry Hole Abandoned

Date

JAN 3 1945 19

S. J. LEWIS Scout

Pool Name StoltenbergMap No. 55 Sec. 21 Twp. 17 R. 10WWell No. 1 ScheffmannPhillips CompanyABANDONED Contractor

SE SW

SECTION PLAT

 Ft. from N. Line330 Ft. from S. Line330 Ft. from E. Line Ft. from W. Line

Ellsworth

Location Rig up

Drilling and Remarks:

Comp 9278
CE 73315

RECORD

Cased in., ft.Sand Gas Oil Total Depth 3350

PRODUCTION

1st 24 hrs. Nat. 1st 24 hrs. after shot Gas Cu. Ft.Dry Hole Abandoned

Date

JAN 24 1945 19

S. J. LEWIS Scout