

KANSAS

Ellsworth

Form 51-5M-7-39-Palace


Section 21 Township 17 Range 9-W

Well No. #1 Jensen

Company Bartlett et al

NORTH Semi-Wildcat

16

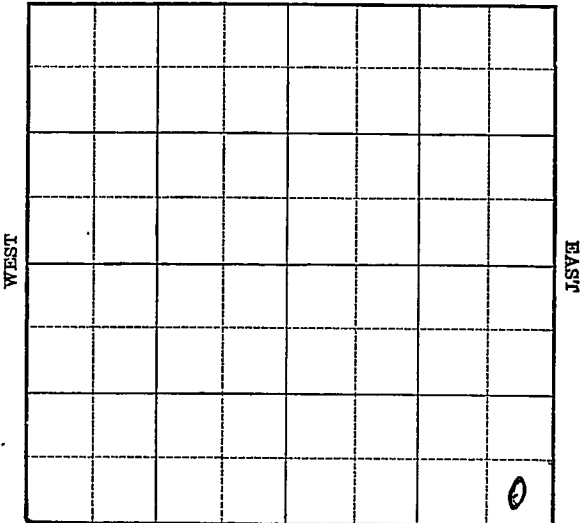

SOUTH

Ellsworth

KANSAS

Map No. 45 Sec. 21 Twp. 17 R. 9WWell No. 1 Jensen

Bartlett et al

Company

Contractor

FIRST REPORT

SE/C

 Ft. from N. Line330 Ft. from S. Line330 Ft. from E. Line Ft. from W. Line

SECTION PLAT

SEMI-WILDCAT

RECORD

Location Cased in., ft.Rig up Sand

Drilling and Remarks:

Gas 10" - 239'Oil Dr1g. 1850'Total Depth

PRODUCTION

1st 24 hrs. Nat. 1st 24 hrs. after shot Gas Cu. Ft.Dry Hole Abandoned

Date

DEC 13 1939 19

S. J. LEWIS

Scout

Map No. 45 Sec. 21 Twp. 17 R. 9WWell No. 1 JensenBartlett et al


Company

Contractor

ABANDONED

SE/C

SECTION PLAT

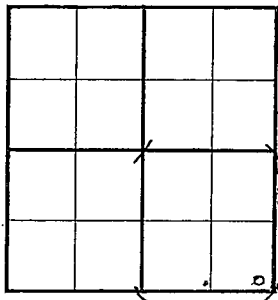 Ft. from N. Line330 Ft. from S. Line330 Ft. from E. Line Ft. from W. Line

SEMI-WILDCAT

Location Rig up

Drilling and Remarks:

*CR 83310**No show*

RECORD

Cased in., ft.Sand Gas Oil Total Depth 3325

PRODUCTION

1st 24 hrs. Nat. 1st 24 hrs. after shot Gas Cu. Ft.Dry Hole Abandoned

Date

JAN 3 1940

19

S. L. LEWIS Scout