


Section 21 Township 17 Range 8-W

Well No. #1 Janssen

Company Nelson Drlg.

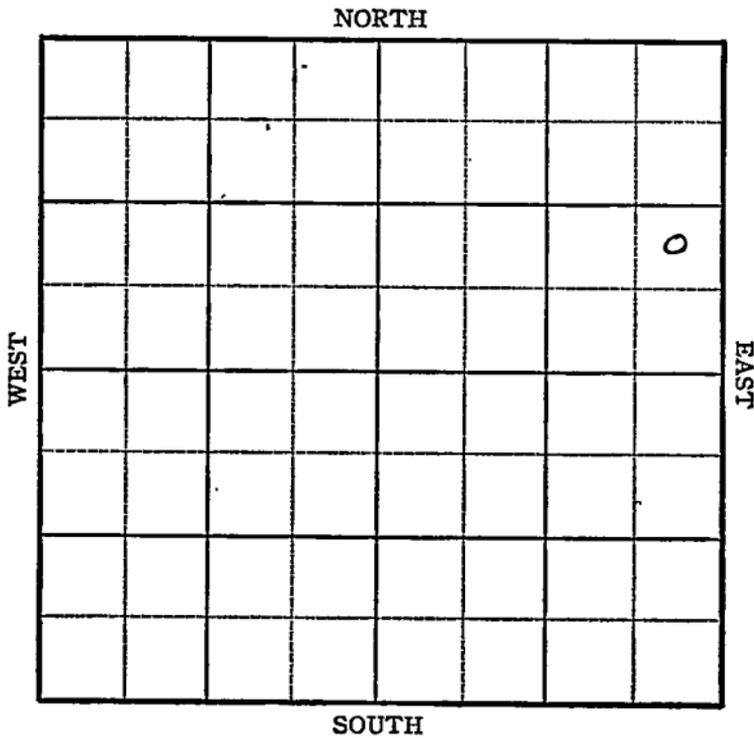


Sec. 21 Twp. 17 R. 8W

Well No. #1 Janssen Farm  
Nelson Drlg. Company

Edwards

\_\_\_\_\_ Ft. from N. Line  
990 \_\_\_\_\_ Ft. from S. Line  
330 \_\_\_\_\_ Ft. from E. Line  
\_\_\_\_\_ Ft. from W. Line

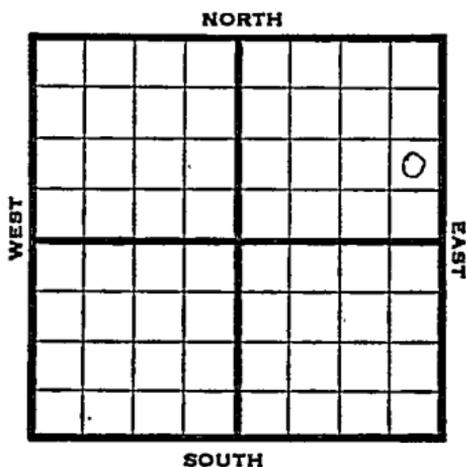

NE SE NE

1946	Elev.	REPORT
3/13	RUR	
3/21	"	
3/28	8" - 230'	Drlg. 2102'
4/4	Arb. 3195	
	TD 3231	
	5" @ 3221	RUST
4/10	Arb 3195	
	TD 3231	
4/17	Arb. 3195	
	5" @ 3221	
	42 shots 3200-3224	
	1000 acid.	
	TD 3231	
	Depth Pot. 3000	
	Grav. 41.0	

COMPLETED



Edwards

Kansas Pool Name

**KANSAS**  
Map No. *H/S*

Sec. 21

Twp. 17

R. 8W

Well No. 1 Janssen

Nelson Drlg.

Company

**COMPLETED**

Contractor

NE SE NE

**SECTION PLAT**

\_\_\_\_\_ Ft. from N. Line

990 Ft. from S. Line

330 Ft. from E. Line

\_\_\_\_\_ Ft. from W. Line

			2

Ellsworth County

Location \_\_\_\_\_

Rig up \_\_\_\_\_

Drilling and Remarks:

*ca 3195*  
*5" @ 3221*  
*42 shots @ 3200-24*  
*1000 @ acid*  
*Sept 12 @ 3000*  
*412/91*

**RECORD**

Cased \_\_\_\_\_ in., \_\_\_\_\_ ft.

Sand \_\_\_\_\_

Gas \_\_\_\_\_

Oil \_\_\_\_\_

Total Depth *3231*

**PRODUCTION**

1st 24 hrs. Nat. \_\_\_\_\_

1st 24 hrs. after shot \_\_\_\_\_

Gas \_\_\_\_\_ Cu. Ft.

Dry Hole \_\_\_\_\_

Abandoned \_\_\_\_\_

Date

APR 17 1946

19

S. J. LEWIS

Scout