

KANSAS Ellsworth county

Section 21 Township 17 Range 8W

Well No. #2, Janssen

Company Nelson Drlg.

NORTH

							Q

SOUTH

WEST

EAST

KANSAS

Ellsworth County

Sec. 21 Twp. 17 R. 8W

Well No. #2 Janssen Farm

Nelson Drlg. Company

Edwards


990 Ft. from N. Line

Ft. from S. Line

330 Ft. from E. Line

Ft. from W. Line

SE NE NE

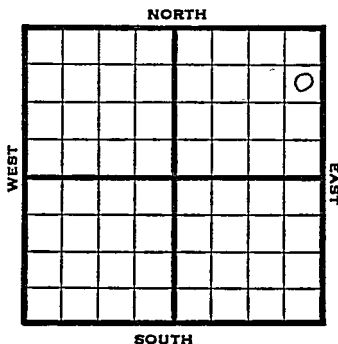

1946 Elev. 1792 REPORT

4/17 10" @ 175'
Drlg. 2125'

4/23 Arb 3193-
TD 3201
5" @ 3201 Treat

5/1 Arb. 3193
5" @ 3201
TD 3242'
1000 acid.
Pump 198 Pot.
Grav. 41.0

COMPLETED

KANSAS ~~Kansas~~ Pool Name EdwardsMap No. 45 Sec. 21 Twp. 17 R. 8WWell No. 2 JanssenNelson Drlg.

Company

FIRST REPORT

Contractor

SE NE NE

SECTION PLAT

990 Ft. from N. Line

Ft. from S. Line

330 Ft. from E. Line

Ft. from W. Line

			o

Ellsworth CountyLocation ✓

Rig up

Drilling and Remarks:

10" @ 175

Drlg. 2125

RECORD

Cased in., ft.Sand Gas Oil Total Depth

PRODUCTION

1st 24 hrs. Nat. 1st 24 hrs. after shot Gas Cu. Ft.Dry Hole Abandoned

Date

APR 17 1946 19S. J. LEWIS

Scout

KANSAS Kansas Pool Name Edwards PoolMap No. 45 Sec. 21 Twp. 17 R. 8WWell No. 2 JanssenNelson Drlg. Company

COMPLETED

Contractor

SE NE NE

E11792
SECTION PLAT990 Ft. from N. Line Ft. from S. Line330 Ft. from E. Line Ft. from W. Line

Ellsworth CountyLocation Rig up

Drilling and Remarks:

Per Y3183
5" @ 320'
1000 acid
Pump 198 Pst

#12 Gr

RECORD

Cased in., ft.Sand Gas Oil Total Depth 12142

PRODUCTION

1st 24 hrs. Nat. 1st 24 hrs. after shot Gas Cu. Ft.Dry Hole Abandoned

Date

MAY 1 1946 19 S. J. LEWIS Scout