


Section 21 Township 17 Range 8-W

Well No. 1 Johnson

Company C. H. Weaver

NORTH Semi-Wildcat

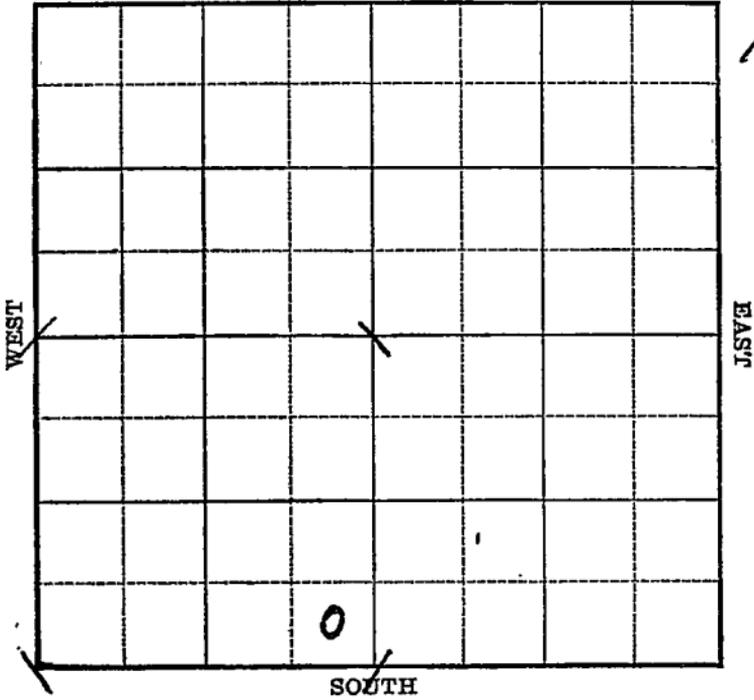

Sec. 21 Twp. 17 R. 8-W

Well No. #1 Johnson Farm

C. H. Weaver Company

(Semi-Wildcat)

_____ Ft. from N. Line


330 Ft. from S. Line

330 Ft. from E. Line

_____ Ft. from W. Line

Elev. Est. 1788' DF.

1785' Gr.

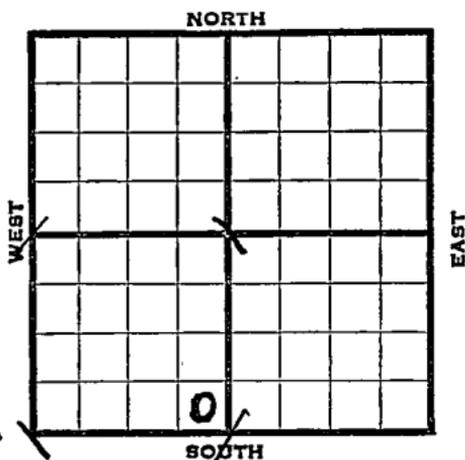

1939	REPORT
4/5	Mat'l.
4/14	"
4/21	10" - 191' Drlg. 1640'
4/28	Lans. 2859' Drlg. 3210'
5/5	Arb. 3237' 6" - 3237'
	T.D. 3238' T.D. 3249'
	3000' oil.
5/10	Arb. 3237'
	6" - 3237'
	T.D. 3249'
	2000 acid.
	Pump 1259 bbls., potential.
	COMPLETED

Map No. 45 Sec. 21 Twp. 17 R. 8W

Well No. 1 Johnson

C. H. Weaver Company

Contractor

COMPLETED

SECTION PLAT

SE SW

_____ Ft. from N. Line

330 Ft. from S. Line

330 Ft. from E. Line

_____ Ft. from W. Line

SEMI-WILDCAT

Location _____

Rig up _____

Drilling and Remarks:

Cor 8-3237
6" @ 3237
2000 acid
Pump 1259 P.D.

RECORD

Cased _____ in., _____ ft.

Sand _____

Gas _____

Oil _____

Total Depth 3249

PRODUCTION

1st 24 hrs. Nat. 1

1st 24 hrs. after shot _____

Gas _____ Cu. Ft.

Dry Hole _____

Abandoned _____

Date

MAY 10 1939 19

S. J. LEWIS Scout