


Section 21 Township 17 Range 8-W

Well No. #2 Baker

Company Continental et al

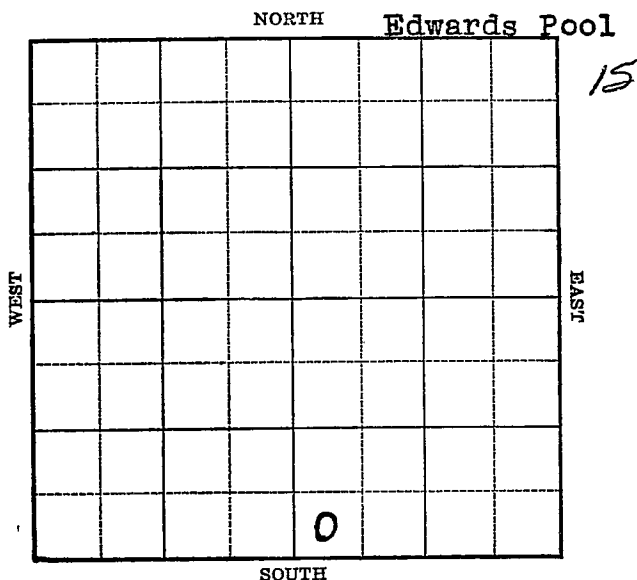

KANSAS


Ellsworth

Sec. 27 Twp. 17 R. 8-WWell No. #2 Baker FarmContinental et al Company

(Edwards)

 Ft. from N. Line330 Ft. from S. Line Ft. from E. Line330 Ft. from W. Line

Elev. 1790

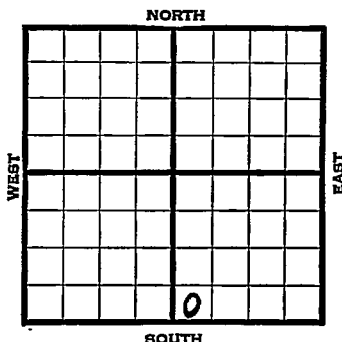

1939	REPORT
6/27	Rotary.
6/29	10" - 206' Drlg. 1785'
7/6	Drlg. 3146'
7/13	Arb. 3226' 7" - 3227'
	1600' oil 5 hrs. at 3237' Drlg.
7/19	Arb. 3226'
	7" - 3227'
	T.D. 3240'
	5000 acid.
	Pump 841 bbls.
	COMPLETED

Ellsworth KANSAS

Map No. 45 Sec. 21 Twp. 17 R. 8WWell No. 2 BakerContinental etal Company

Contractor

FIRST REPORT

SW SE

 Ft. from N. Line330 Ft. from S. Line Ft. from E. Line330 Ft. from W. Line

SECTION PLAT

		6	

EDWARDS POOL

Location Rig up

Drilling and Remarks:

ROTARY

RECORD

Cased in., ft.Sand Gas Oil Total Depth

PRODUCTION

1st 24 hrs. Nat. 1st 24 hrs. after shot Gas Cu. Ft.Dry Hole Abandoned

Date

JUN 21 1933 19

S. J. LEWIS Scout

Ellsworth

KANSAS

Map No. 45 Sec. 21 Twp. 17 R. 8WWell No. 2 BakerContinental etal

Company

Contractor

COMPLETED

SW SE

SECTION PLAT

 Ft. from N. Line330 Ft. from S. Line Ft. from E. Line330 Ft. from W. Line

EDWARDS POOL

Location Rig up

Drilling and Remarks:

*Art 3226**7" @ 3227.**5000 Acid**Pump 841*

RECORD

Cased in., ft.Sand Gas Oil Total Depth 3240

PRODUCTION

1st 24-hrs. Nat. 1st 24-hrs. after shot Gas Cu. Ft.Dry Hole Abandoned

Date

JUL 15 1939

S. J. LEWIS

Scout