

# KANSAS


Form 51-5M-7-39-Palace

Ellsworth Co., Kansas  
Genesee Pool

Section 21 Township 17 Range 8W

Well No. #3 Baker

Company Continental etal

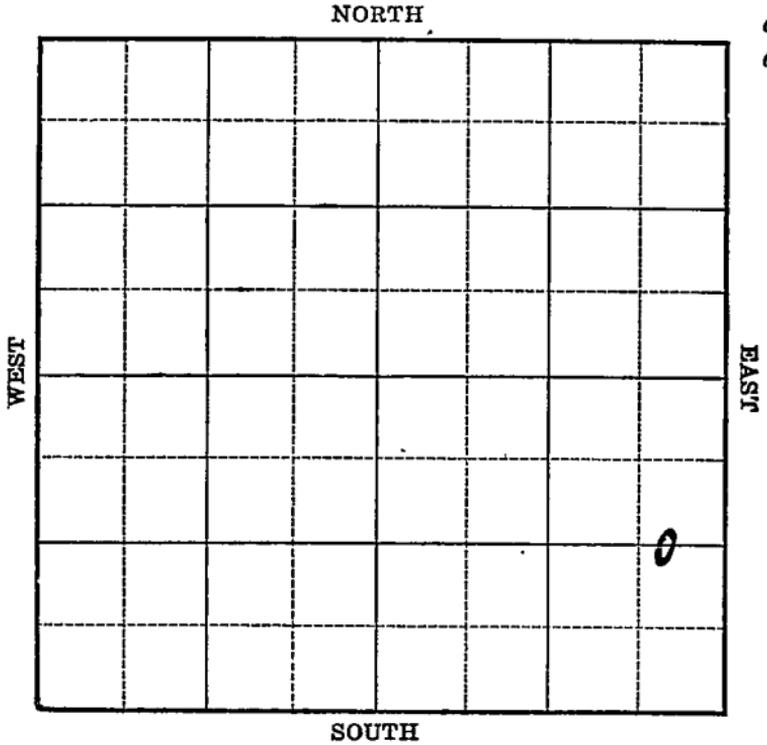





Map No. 45 Sec. 21 Twp. 17 R. 8WWell No. 3 BakerContinental etal Company

Contractor

**COMPLETED**

G E L S E


1320 Ft. from N. Line

\_\_\_\_\_ Ft. from S. Line

440 Ft. from E. Line

\_\_\_\_\_ Ft. from W. Line

## SECTION PLAT

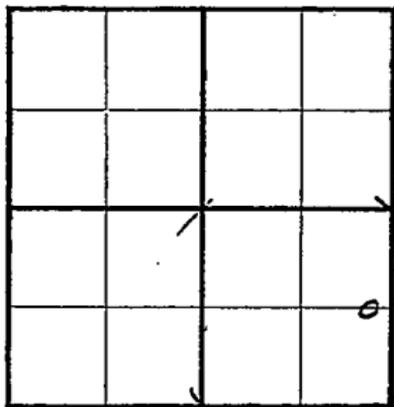

GENESEEO POOL

Location \_\_\_\_\_

Rig up \_\_\_\_\_

Drilling and Remarks:

*1000 acid**Pump. Pot.**640 bbls.*

## RECORD

Cased \_\_\_\_\_ in., \_\_\_\_\_ ft.

Sand *3260*

Gas \_\_\_\_\_

Oil \_\_\_\_\_

Total Depth *3265*

## PRODUCTION

1st 24 hrs. Nat. \_\_\_\_\_

1st 24 hrs. after shot \_\_\_\_\_

Gas \_\_\_\_\_ Cu. Ft.

Dry Hole \_\_\_\_\_

Abandoned \_\_\_\_\_

Date

JUL 31 1940 19

S. J. LEWIS

Scout