


Section 21 Township 17 Range 8W

Well No. #5 Jansen

Company Nelson Drlg.

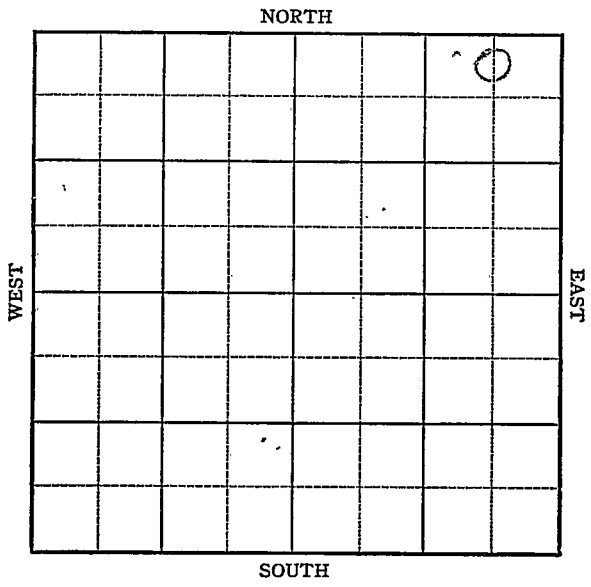

KANSAS

Ellsworth County

Sec. 21 Twp. 17 R. 8W

Well No. #5 Jansen Farm
Nelson Drlg. Company

Edwards


330 Ft. from N. Line

 Ft. from S. Line

660 Ft. from E. Line

 Ft. from W. Line

CNL NE NE

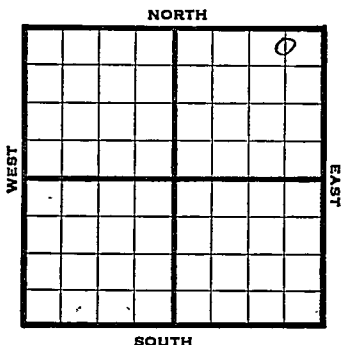

1946

1772

R E P O R T

7/24 RUR

7/30 10" @ 185'
Drlg 2585'

8/6 Cong 3168
Arb 3172
TD 3248
7" @ 3248'

8/13 49 shots 3190-3211
1000 acid
Pump 2½ oil RH

8/20 " "

8/28 Arb 3172'
7" @ 3248'
Perf 2000 gal acid
Pump 231 Pot
3 9 GRAV.
TD 3248

COMPLETED


KANSAS Kansas Pool Name EdwardsMap No. 45 Sec. 21 Twp. 17 R. 8WWell No. 5 JansenNelson Drlg. Company

FIRST REPORT

Contractor

C N L NE NE

SECTION PLAT

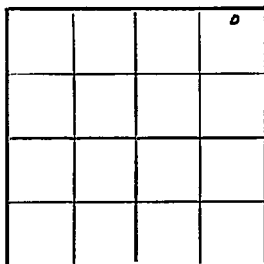330 Ft. from N. Line Ft. from S. Line660 Ft. from E. Line Ft. from W. LineEllsworth CountyLocation Rig up

Drilling and Remarks:

R U R

RECORD

Cased in., ft.Sand Gas Oil Total Depth

PRODUCTION

1st 24 hrs. Nat. 1st 24 hrs. after shot Gas Cu. Ft.Dry Hole Abandoned

Date

JUL 24 1946 19 S. J. LEWIS Scout

KANSAS

Kansas

Pool Name

Edwards Pool

Map No. 45 Sec. 21 Twp. 17 R. 8WWell No. 5 Jansen

Nelson Drlg.

Company

COMPLETED

Contractor

C N L NE NE

E. 1772


SECTION PLAT

330 Ft. from N. Line

Ft. from S. Line

660 Ft. from E. Line

Ft. from W. Line

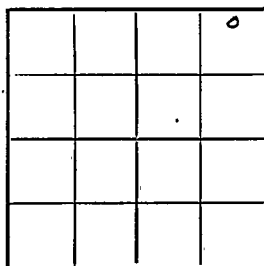

Ellsworth County

Location

Rig up

Drilling and Remarks:

Per 83172

7' to 3248.

Per

2000000000

Pump 231 Per

3926

RECORD

Cased _____ in. _____ ft.

Sand _____

Gas _____

Oil _____

Total Depth 3248

PRODUCTION

1st 24 hrs. Nat. _____

1st 24 hrs. after shot _____

Gas _____ Cu. Ft.

Dry Hole _____

Abandoned _____

Date

AUG 28 1946

19

S. I. LEWIS

Scout