


Section 21 Township 17 Range 8W

Well No. 3 Janssen

Company Nelson Drlg.

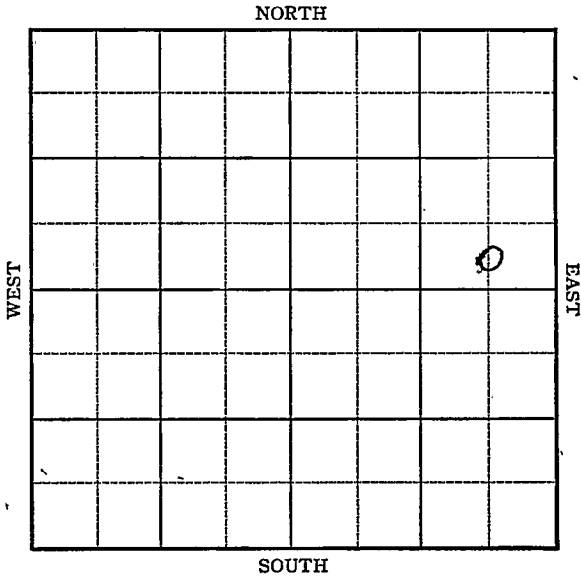

KANSAS

Ellsworth County ✓

Sec. 21 Twp. 17 R. 8W

Well No. #3 Janssen Farm

Nelson Drlg. Company

Edwards

\_\_\_\_\_ Ft. from N. Line

330


\_\_\_\_\_ Ft. from S. Line

660

\_\_\_\_\_ Ft. from E. Line

\_\_\_\_\_ Ft. from W. Line

CSL SE NE

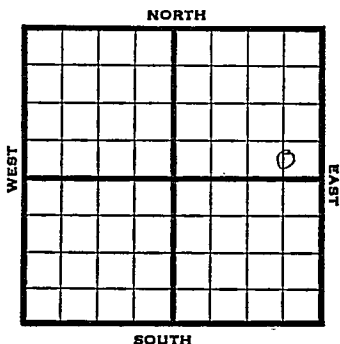

Elev. 1791

REPORT

1946

4/24

10" @ 171'

5/1

Drlg 3120'

5/7

Chat 3184

TD 3188-7" @ 3188

RUST

5/15

Arb. 3184

7" @ 3188

4000 acid.

TD 3190

Pump 805 Pot.

Grav. 39.6

COMPLETED

**KANSAS**

Pool Name Edwards

Map No. 43 Sec. 21 Twp. 17 R. 8W

Well No. 3 Janssen

Nelson Drlg. Company

**FIRST REPORT** Contractor

C S L SE NE

**SECTION PLAT**

\_\_\_\_\_ Ft. from N. Line

330 Ft. from S. Line

660 Ft. from E. Line

\_\_\_\_\_ Ft. from W. Line

|  |  |  |   |
|--|--|--|---|
|  |  |  |   |
|  |  |  |   |
|  |  |  | o |
|  |  |  |   |
|  |  |  |   |

Ellsworth County

Location \_\_\_\_\_

Rig up \_\_\_\_\_

Drilling and Remarks:

10" @ 171

**RECORD**

Cased \_\_\_\_\_ in., \_\_\_\_\_ ft.

Sand \_\_\_\_\_

Gas \_\_\_\_\_

Oil \_\_\_\_\_

Total Depth \_\_\_\_\_

**PRODUCTION**

1st 24 hrs. Nat. \_\_\_\_\_

1st 24 hrs. after shot \_\_\_\_\_

Gas \_\_\_\_\_ Cu. Ft.

Dry Hole \_\_\_\_\_

Abandoned \_\_\_\_\_

Date

APR 24 1946 1946

S. J. LEWIS Scout

Kansas Pool Name Edwards Pool  
 Map No. 25 Sec. 21 Twp. 17 R. 8W

Well No. 3 Janssen

Nelson Drlg. Company

**COMPLETED**

Contractor

C S L SE NE

E1,1791  
SECTION PLAT

|  |  |  |   |
|--|--|--|---|
|  |  |  |   |
|  |  |  |   |
|  |  |  | o |
|  |  |  |   |
|  |  |  |   |

\_\_\_\_\_ Ft. from N. Line

330 Ft. from S. Line

660 Ft. from E. Line

\_\_\_\_\_ Ft. from W. Line

**Ellsworth County**

Location \_\_\_\_\_

Rig up \_\_\_\_\_

Drilling and Remarks:

CR 3184

7" CR 3188

4000 acid

Pump 805 1st

296/2

**RECORD**

Cased \_\_\_\_\_ in, \_\_\_\_\_ ft.

Sand \_\_\_\_\_

Gas \_\_\_\_\_

Oil \_\_\_\_\_

Total Depth 3190

**PRODUCTION**

1st 24 hrs. Nat. \_\_\_\_\_

1st 24 hrs. after shot \_\_\_\_\_

Gas \_\_\_\_\_ Cu. Ft.

Dry Hole \_\_\_\_\_

Abandoned \_\_\_\_\_

Date

MAY 15 1946

19

S. J. LEWIS

Scout