


Section 21 Township 17 Range 8W

Well No. #4 Janssen

Company Nelson Drlg.

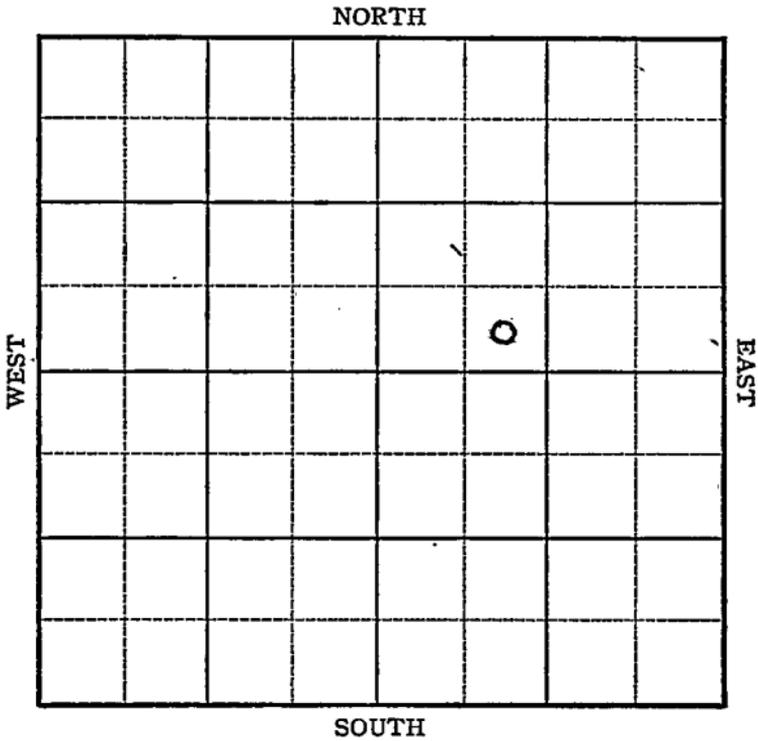

Sec. 21 Twp. 17 R. 8W

Well No. #4, Janssen Farm

Nelson Drlg. Company

Edwards


 Ft. from N. Line

330 Ft. from S. Line

 Ft. from E. Line

990 Ft. from W. Line

SE SW NE

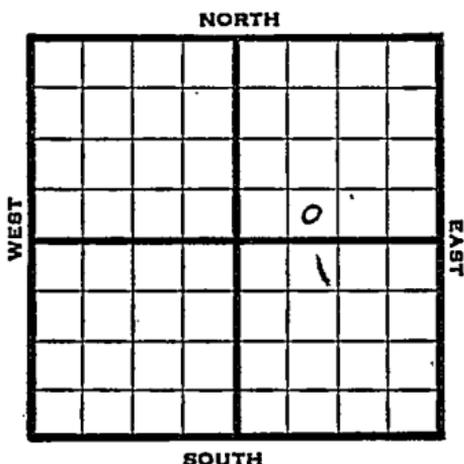

1946 Ele7. 1786 REPORT

6/12 RUR
 6/18 10" @ 180
 Drlg 2600'
 6/26 Lans 2810 Simp 3218'
 Cong 3202 Arb 3268 TD
 7" @ 3 268 RUST
 7/3 Arb. 3268
 7" @ 3268
 24 shots 3268-3273
 1000 acid.
 TD 3277
 Echo Pot. 4437
 Max. 3000
 Grav. 40.6

COMPLETED

KANSAS Kansas Pool Name Edwards

Map No. 45 Sec. 21 Twp. 17 R. 8W

Well No. 4 Janssen

Nelson Drlg. Company

FIRST REPORT Contractor

SE SW NE

SECTION PLAT

_____ Ft. from N. Line

330 Ft. from S. Line

_____ Ft. from E. Line

990 Ft. from W. Line

		o	

Ellsworth County

Location _____

Rig up _____

Drilling and Remarks:

RUR

RECORD

Cased _____ in., _____ ft.

Sand _____

Gas _____

Oil _____

Total Depth _____

PRODUCTION

1st 24 hrs. Nat. _____

1st 24 hrs. after shot _____

Gas _____ Cu. Ft.

Dry Hole _____

Abandoned _____

Date

JUN 12 1946

19

S. J. LEWIS

Scout

