

Sec. 21 Twp. 17 R. 8-W

Well No. #7 Janssen Farm

N C R A Company


Edwards Pool

 Ft. from N. Line

990 Ft. from S. Line

 Ft. from E. Line

990 Ft. from W. Line

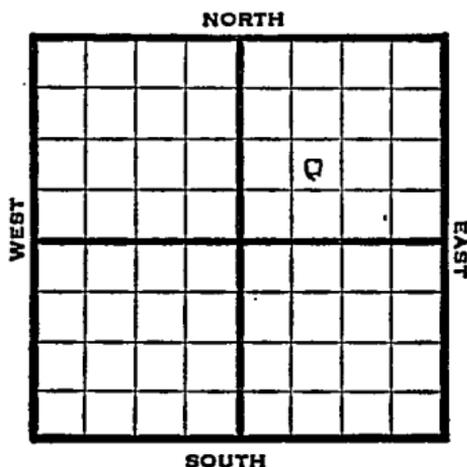

NE SW NE - - -

REPORT

1947 Elev. 1776'

4/30 8" @ 198'
Drlg 2600'

5/7 Arb 3251-52
TD 3252'
5" @ 3252
RUST

5/13 TD 3255'
500 Acid.

5/23 Pump 3 1/2 bbls oil PH

5/27 " "

6/3 " "

6/11 Arb. 3251'
5" @ 3253'
500 Acid
Pump 16l Pot
46.0 Gr.
TD 3255'

COMPLETED

Map No. 45 Sec. 21 Twp. 17 R. 8W

Well No. 7 Janssen

N C R A Company

COMPLETE Contractor

NE SW NE

E 11776
SECTION PLAT

		6	

_____ Ft. from N. Line

990 Ft. from S. Line

_____ Ft. from E. Line

990 Ft. from W. Line

Ellsworth County

Location _____

Rig up _____

Drilling and Remarks:

CR 83257
5-10-3253
500 rods
Pump 16/18

46 2/3

RECORD

Cased _____ in., _____ ft.

Sand _____

Gas _____

Oil _____

Total Depth 3255

PRODUCTION

1st 24 hrs. Nat. _____

1st 24 hrs. after shot _____

Gas _____ Cu. Ft.

Dry Hole _____

Abandoned _____

Date

JUN 11 1947

19

S. J. LEWIS

Scout