


Section 21 Township 17 Range 8-W

Well No. #9 Janssen

Company N C R A
Edwards

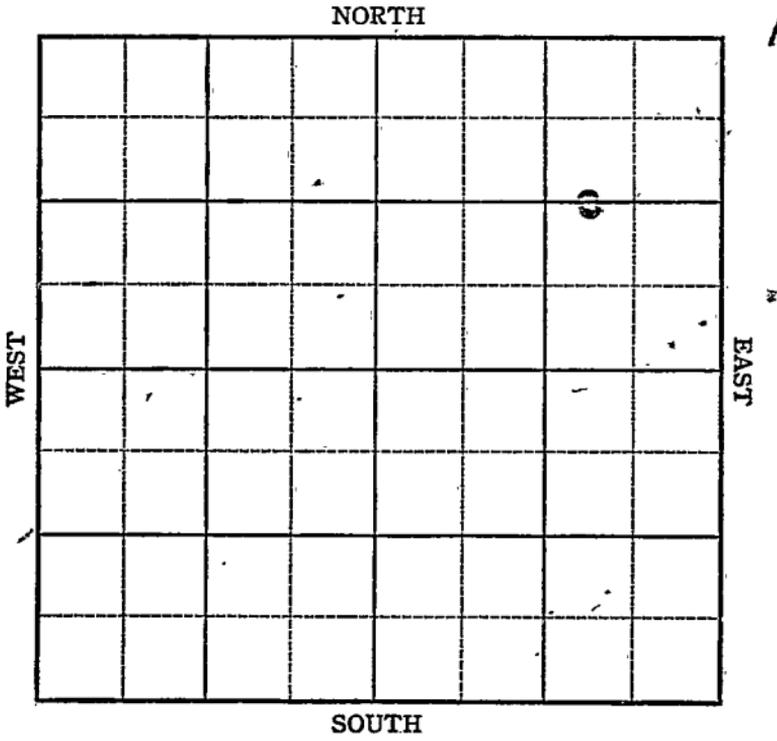

7
X

Sec. 21 Twp. 17 R. 8-W

Well No. #9 Janssen Farm

N C R A Company

Edwards Pool


1320 Ft. from N. Line

_____ Ft. from S. Line

990 Ft. from E. Line

_____ Ft. from W. Line

C W L E $\frac{1}{2}$ NE

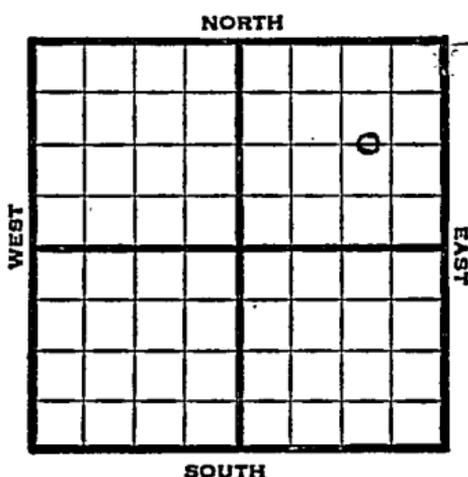

1947

REPORT

Elev. 1719'

6/11 Location

6/17 8" @ 193
Drilling 1400'

6/24 Arbuckle 3173-77 TD
5" @ 3174'
RUST

7/1 "

7/8 TD 3193'
2800' oil 8 hrs.

7/16 " "

7/23 Arbuckle 3173'
5" @ 3174'
Echo Pot 3000
Gr. 47
T.D. 3193'
Complete

COMPLETED

Map No. _____ Sec. 21 Twp. 17 R. 8W

Well No. 9 Janssen

N C R A Company

FIRST REPORT

Contractor

C W L E $\frac{1}{2}$ NE

SECTION PLAT

1320 Ft. from N. Line

_____ Ft. from S. Line

990 Ft. from E. Line

_____ Ft. from W. Line

			5
		1	

Ellsworth County

Location X

Rig up _____

Drilling and Remarks:

RECORD

Cased _____ in., _____ ft.

Sand _____

Gas _____

Oil _____

Total Depth _____

PRODUCTION

1st 24 hrs. Nat. _____

1st 24 hrs. after shot _____

Gas _____ Cu. Ft.

Dry Hole _____

Abandoned _____

Date

JUN 11 1947 '19

S. I. LEWIS Scout

Map No. 45 Sec. 21 Twp. 17 R. 8W

Well No. 9 Janssen

N C R A

Company

COMPLETE

Contractor

C W L E¹/₂ NE

E11749


SECTION PLAT

1320 Ft. from N. Line

_____ Ft. from S. Line

990 Ft. from E. Line

_____ Ft. from W. Line

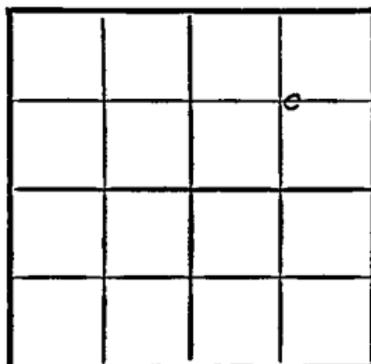

Ellsworth County

RECORD

Location _____

Cased _____ in., _____ ft.

Rig up _____

Sand _____

Drilling and Remarks:

Gas _____

Oil _____

Total Depth 8123

Cur 8123
5" C 3174
Ech 8123 3000

PRODUCTION

1st 24 hrs. Nat. _____

1st 24 hrs. after shot _____

Gas _____ Cu. Ft.

Dry Hole _____

Abandoned _____

47 0/8

Date

JUL 23 1947 19

S. J. LEWIS Scout