

# KANSAS

Form 51-5M-7-39-Palace


Ellsworth

Section 21 Township 17 Range 8-W

Well No. #2 Johnson

Company C. H. Weaver et al

NORTH Edwards Pool

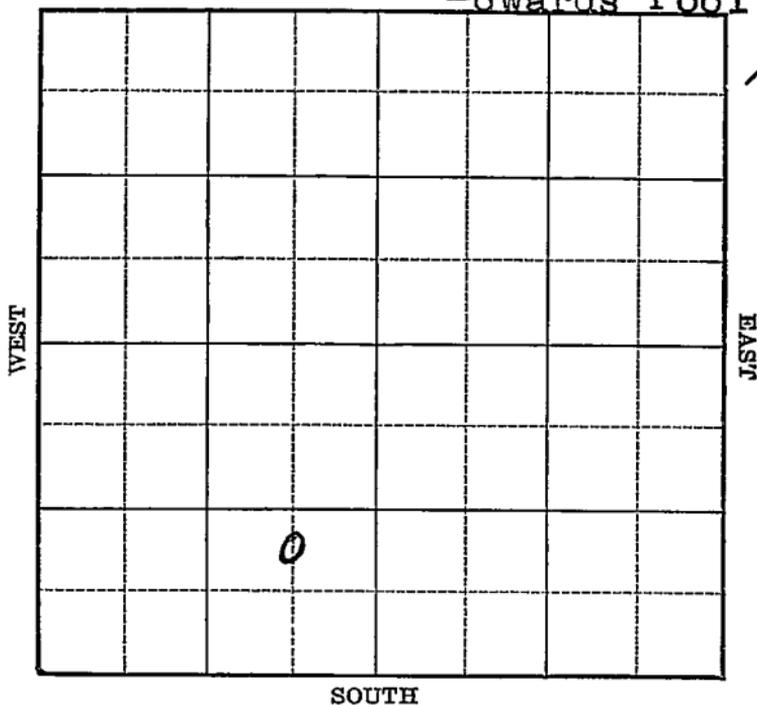

Sec. 21 Twp. 17 R. 8-W

Well No. #2 Johnson Farm

C. H. Weaver et al Company

(**Edwards**)


\_\_\_\_\_ Ft. from N. Line

990 Ft. from S. Line

660 Ft. from E. Line

\_\_\_\_\_ Ft. from W. Line

**Elev 1788**

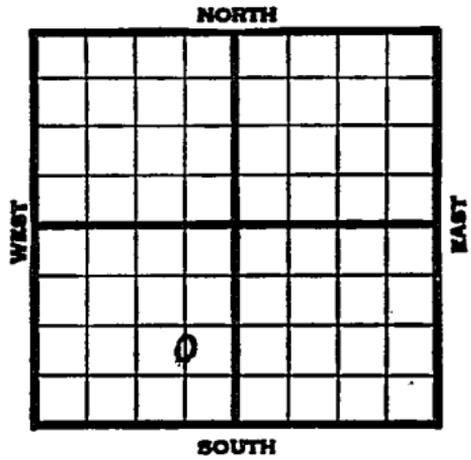

1940	REPORT
1/10	Rotary.
1/18	Rigging up.
1/25	10" - 184' Drlg. 380'
2/1	Drlg. 2225'
2/8	Drlg. 3282'
2/15	Arb. 3349' T.D. 3354' No shows Shut down.
2/23	" "
2/29	" "
3/6	Arb. 3349'
	T.D. 3354'
	<b>ABANDONED</b>

Map No. 45 Sec. 21 Twp. 17 R. 8WWell No. 2 JohnsonC. H. Weaver et al

Company

Contractor

**FIRST REPORT****C N L SE SW**         Ft. from N. Line990 Ft. from S. Line660 Ft. from E. Line         Ft. from W. Line**SECTION PLAT**

	o		

**EDWARDS POOL**Location                                 Rig up                                 

Drilling and Remarks:

**Rotary****RECORD**Cased                  in.,                  ft.Sand                                 Gas                                 Oil                                 Total Depth                                 **PRODUCTION**1st 24 hrs. Nat.                                 1st 24 hrs. after shot                                 Gas                                  Cu. Ft.Dry Hole                                 Abandoned                                 

Date

JAN 10 1940 19S. I. LEWIS Scout

Ellsworth **KANSAS**

Map No. 45 Sec. 21 Twp. 17 R. 8W

Well No. 2 Johnson

C. H. Weaver etal Company

Contractor

**ABANDONED**

C N L SE SW

**SECTION PLAT**

	0		

\_\_\_\_\_ Ft. from N. Line

990 Ft. from S. Line

660 Ft. from E. Line

\_\_\_\_\_ Ft. from W. Line

**EDWARDS POOL**

Location \_\_\_\_\_

Rig up \_\_\_\_\_

Drilling and Remarks: \_\_\_\_\_

*W + A*

**RECORD**

Cased \_\_\_\_\_ in., \_\_\_\_\_ ft.

Sand Artuckle 3349

Gas \_\_\_\_\_

Oil \_\_\_\_\_

Total Depth 3354

**PRODUCTION**

1st 24 hrs. Nat. \_\_\_\_\_

1st 24 hrs. after shot \_\_\_\_\_

Gas \_\_\_\_\_ Cu. Ft.

Dry Hole \_\_\_\_\_

Abandoned \_\_\_\_\_

Date

MAR 6 1940 19

S. J. LEWIS Scout