


Section 21 Township 17 Range 4 WWell No. #1 DahlstonCompany Texas Co.

NORTH

15

WEST

EAST

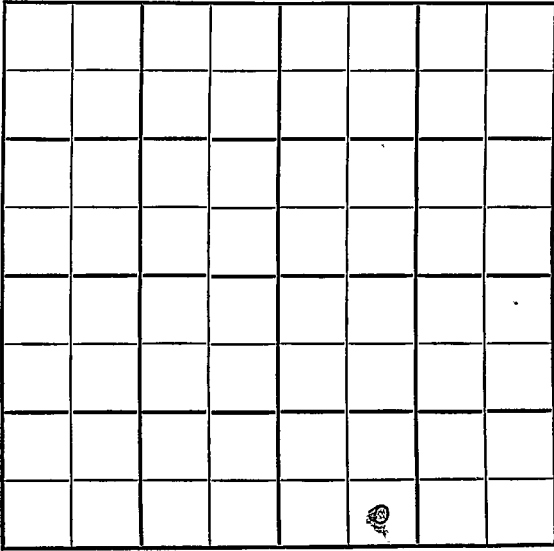

SOUTH

McPherson

KANSAS

|      |      |    |
|------|------|----|
| SEC. | TWP. | R. |
| 21   | 17   | 4W |

WELL NO.

#1 Dahlston

FARM

COMPANY

Texas Co.

CONTRACTOR


Wildcat

\_\_\_\_\_ Ft. from N. Line

\_\_\_\_\_ Ft. from S. Line

\_\_\_\_\_ Ft. from E. Line

\_\_\_\_\_ Ft. from W. Line

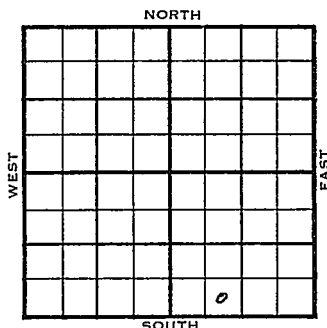

SE SW SE

1955

ELEVATION

1380'

REPORT

9/7

Cellar &amp; Pits

10/5

Comm 9-12-55

10 3/4" @ 455-300

L 2389

M 3038

Mq 3514

V 3561

S 3634

A 3695

TD 3721

DST 3040-51 open 1 hr Rec 195' sw

1008/30" DST 3515-20 open 1 hr

Rec 90' socmsw 1190/20" DST

3649-59 open 1 hr Rec 165' msd

1208/30" D &amp; A

ABANDONED

County

~~McPherson~~

Elev.

Sec.

21

Twp.

17

Rge.

14W

Company

Texas Company

Farm Name

Dahliston

No.

1

TOPS

DEPTH

LOG

DATUM

Loc. in Sec.

Anh.

Tp.

H.

Tr.

Dg.

Bl.

L.

K.C.

B.K.C.

Ce.

C.

M.

M.

K.

Mz.

Mq.

V.

S.

S.

A.

R.

P.E.

G.

T.D.


SE SW SE

Geol.

Contr.

Pool

Wildcat

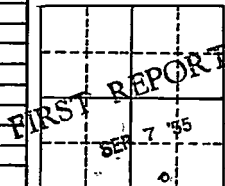

Date Comm.

Cellar &amp; pits

County McPherson Elev. 1380Sec. 21 Twp. 17 Rge. 4WCompany Texas CompanyFarm Name Dahlston No. 1

TOPS

DEPTH

LOG

DATUM

Loc. in Sec. \_\_\_\_\_

Anh. \_\_\_\_\_

Tp. \_\_\_\_\_

H. \_\_\_\_\_

Tr. \_\_\_\_\_

Dg. \_\_\_\_\_

Bl. \_\_\_\_\_

L. \_\_\_\_\_

K.C. \_\_\_\_\_

B.K.C. \_\_\_\_\_

Ce. \_\_\_\_\_

C. \_\_\_\_\_

M. \_\_\_\_\_

M. \_\_\_\_\_

K. \_\_\_\_\_

Mz. \_\_\_\_\_

Mq. \_\_\_\_\_

V. \_\_\_\_\_

S. \_\_\_\_\_

S. \_\_\_\_\_

A. \_\_\_\_\_

R. \_\_\_\_\_

PE. \_\_\_\_\_

G. \_\_\_\_\_

T.D. \_\_\_\_\_

2389

1009

Geol. \_\_\_\_\_

Contr. \_\_\_\_\_

3038

1658

Braden

Pool \_\_\_\_\_

Wildcat

3574

2134

2561

2181


3634

2254

3695

2315

3721

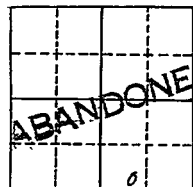Date Comm. 9-12-55 OCT 5 195510 3/4" @ 455/300 DST 3040-51 open1 hr. Rec. 195' sw 1008/30"DST 3515-20 open 1 hr. Rec. 90' socms1190/20" DST 3649-59 open 1 hr.Rec. 165' msw 1208/30"D & A