

Section 21 Township 17 Range 1-W

Well No. 71 Hole


Company H. & M. Oil

Roxbury Pool

NORTH

WEST

EAST

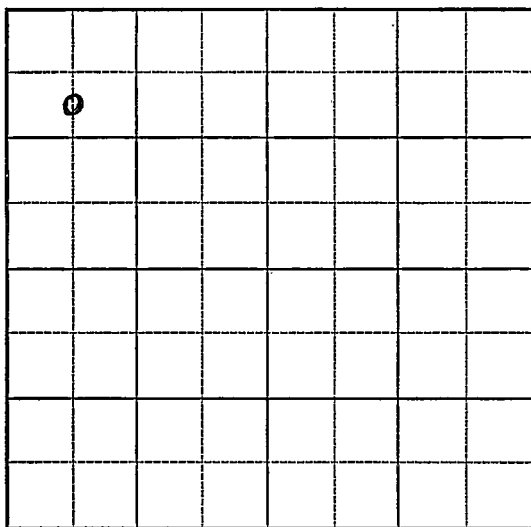

SOUTH

Sec. 21 Twp. 17 R. 1-W

Well No. #1 Tolle Farm

H & M Oil Company

(~~Ranbury~~)


990 Ft. from N. Line

Ft. from S. Line

Ft. from E. Line

660 Ft. from W. Line

Elev. 1309

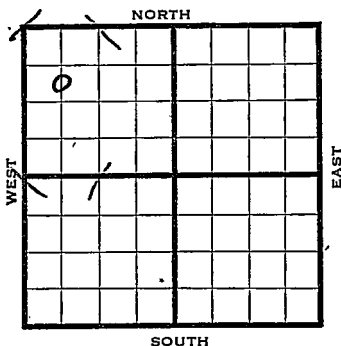

1942

REPORT

7/8 10" - 140'
Drlg. 2262'

7/15 Lans. 2055' Miss. 2643-45' T.D.
7" - 2641' RUST.

7/22 T.D. 2656-2400 oil 17 hrs. 2000 acid

7/29 7" - 2641'
Miss. 2643'
2000 acid
T.D. 2656'
Depth Pot. 1075
Gravity 35.

COMPLETED

KANSAS


McPherson

Map No. 42 Sec. 21 Twp. 17 R. 1WWell No. 1 TolleH. & M. Oil Company**FIRST REPORT** Contractor

C SL NW NW

990 Ft. from N. Line Ft. from S. Line Ft. from E. Line660 Ft. from W. Line

SECTION PLAT

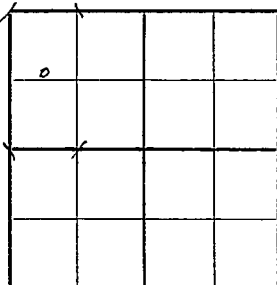

ROXBURY POOL

Location Rig up

Drilling and Remarks:

10" - 140'Drlg. 2262'

RECORD

Cased in., ft.Sand Gas Oil Total Depth

PRODUCTION

1st 24 hrs. Nat. 1st 24 hrs. after shot Gas Cu. Ft.Dry Hole Abandoned

Date

JUL 8 1942 19S. J. LEWIS Scout

Map No. 42 Sec. 21 Twp. 17 R. 1 WWell No. 1 TolleH & M Oil CompanyCOMPLETED Contractor**C SL NW NW****SECTION PLAT**990 Ft. from N. Line Ft. from S. Line Ft. from E. Line660 Ft. from W. Line

o			

ROXBURY POOLLocation Rig up

Drilling and Remarks:

Miss 2643
7" @ 2641
2000 ac
Depth 251075

*35° W***RECORD**Cased in., ft.Sand Gas Oil Total Depth 2656**PRODUCTION**1st 24 hrs. Nat. 1st 24 hrs. after shot Gas Cu. Ft.Dry Hole Abandoned

Date

JUL 29 1942 19S. J. LEWIS Scout