


Ellsworth

Section 22 **KANSAS** Township 17 Range 9W

Well No. #1 Croesch

Company Royer & Farris

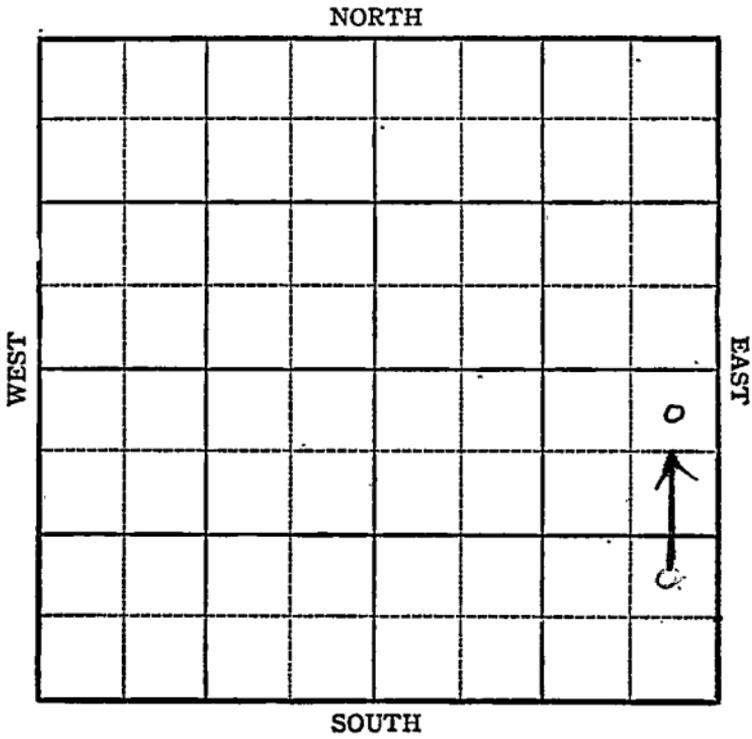


Sec. 22 Twp. 17 R. 9W

Well No. 1 Croesch Farm

Royer & Farris Company

NE SE ~~SW~~

NORTH

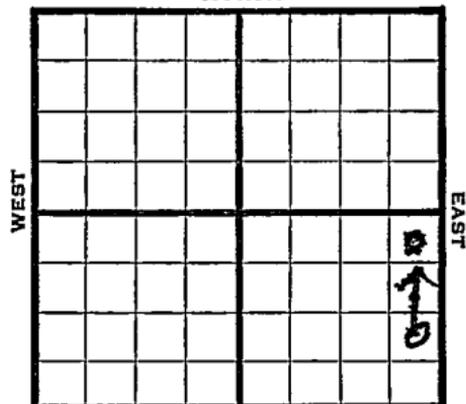

330 Ft. from N. Line

~~990~~ Ft. from S. Line

330 Ft. from E. Line

_____ Ft. from W. Line

Elev. 1763

1944

REPORT

9-13 8" 175 WOC
 9/21 Drlg. 2625
 9/28 Lans 2840
 Simp 3161 SO 3187-91
 Arb 3187
 TD 3191
 5" @ 3189 RUST
 10/4 TD 3191 150' cfluid in 2½ hrs. 50%
 wtr.
 10/11 600' il plus 900' wte
 10/18 Arb 3187
 5" @ 3189
 Pump 50 oil plus 50 wtr.
 TD 3191
 Grav. 40.8

COMPLETED

Pool Name LorraineMap No. 45 Sec. 22 Twp. 17 R. 9WWell No. 1 CroeschRoyert Farres


Company

CORRECTION

Contractor

NE SE

SECTION PLAT

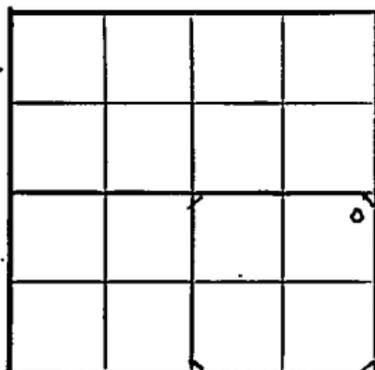330 Ft. from N. Line Ft. from S. Line330 Ft. from E. Line Ft. from W. Line

Ellsworth County

Location _____

Rig up _____

Drilling and Remarks:

Reported

NE SE SE

RECORD

Cased _____ in., _____ ft.

Sand _____

Gas _____

Oil _____

Total Depth _____

PRODUCTION

1st 24 hrs. Nat. _____

1st 24 hrs. after shot _____

Gas _____ Cu. Ft.

Dry Hole _____

Abandoned _____

Date

SEP 20 194419S. J. LEWIS

Scout

KANSAS Pool Name LorraineMap No. 40 Sec. 22 Twp. 17 R. 9WWell No. 1 KroeschRoyer & Farris CompanyCOMPLETED Contractor

NE SE

SECTION PLAT

330 Ft. from N. Line

Ft. from S. Line

330 Ft. from E. Line

Ft. from W. Line

			o

Ellsworth

RECORD

Location _____

Cased _____ in., _____ ft.

Rig up _____

Sand _____

Drilling and Remarks:

Gas _____

Cor 3/18/19

Oil _____

*5" @ 3/18/19*Total Depth 319'*Pump 50 oil + 50 water*

PRODUCTION

1st 24 hrs. Nat. _____

1st 24 hrs. after shot _____

Gas _____ Cu. Ft.

Dry Hole _____

Abandoned _____

Date

OCT 18 1944 19S. J. LEWIS Scout