

KANSAS Ellsworth

Section 22 Township 17 Range 9WWell No. 2 PreussCompany Eldorado Ref.Lorraine
NORTH

							0

SOUTH

16

EAST

WEST

KANSAS

Ellsworth

Sec. 22 Twp. 17 R. 9W ✓

Well No. #2 Preuss- Farm

Eldorado Ref.

Company

Lorraine


 Ft. from N. Line

990' Ft. from S. Line

330' Ft. from E. Line

 Ft. from W. Line

NE SE SE

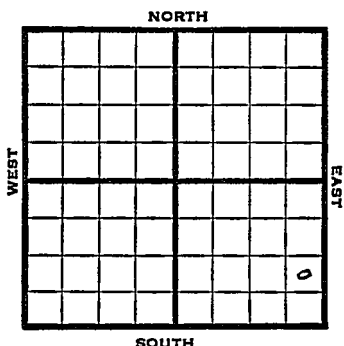

1949

Lev 1770'

REPORT

2/9
2/16

Location
RUR

2/23

8"@ 200

Drlg 2350'

3/2

Lansing 2839'

Arb. 3164-72'

TD 3172

5"@ 3166'

3/8

TD 3181'

20 gals. oil PH

3/16

TD 3192'

Arb. 3164'

5"@ 3166'

1000 acid

Aband.

ABANDONED

Kansas

*Lawrence*Map No. _____ Sec. *22* Twp. *17* R. *9 W*Well No. *2 P. Benson**El Dorado Ref*

Company

FIRST REPORT

Contractor

NE SE SE

SECTION PLAT

			9

_____ Ft. from N. Line

990 Ft. from S. Line*330* Ft. from E. Line

_____ Ft. from W. Line

*Ellsworth*Location *✓*

Rig up _____

Drilling and Remarks:

RECORD

Cased _____ in., _____ ft.

Sand _____

Gas _____

Oil _____

Total Depth _____

PRODUCTION

1st 24 hrs. Nat. _____

1st 24 hrs. after shot _____

Gas _____ Cu. Ft.

Dry Hole _____

Abandoned _____

Date

FEB 9 1949 19

S. J. LEWIS

Scout

Kansas

Lorraine Pool

Map No. K45 Sec. 22 Twp. 17 R. 9WWell No. 2 Preuss


Eldorado Ref.

Company

ABANDONED

Contractor

NE SE SE

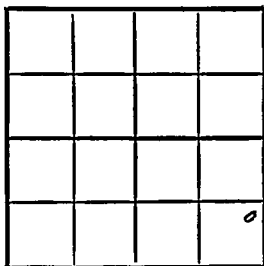E11720
SECTION PLAT Ft. from N. Line990 Ft. from S. Line330 Ft. from E. Line Ft. from W. Line

Ellsworth County

Location Rig up

Drilling and Remarks:

Per 83164
5" @ 3166
1000 acid

RECORD

Cased in., ft.Sand Gas Oil Total Depth 3192

PRODUCTION

1st 24 hrs. Nat. 1st 24 hrs. after shot Gas Cu. Ft.Dry Hole Abandoned

Date

MAR 16 1949 19

S. J. LEWIS Scout