

KANSAS

Form 51-5M-7-39-Palace


Ellsworth

Section 22 Township 17 Range 8-W

Well No. #2 R. Janzen

Company Continental et al

NORTH Edwards Pool

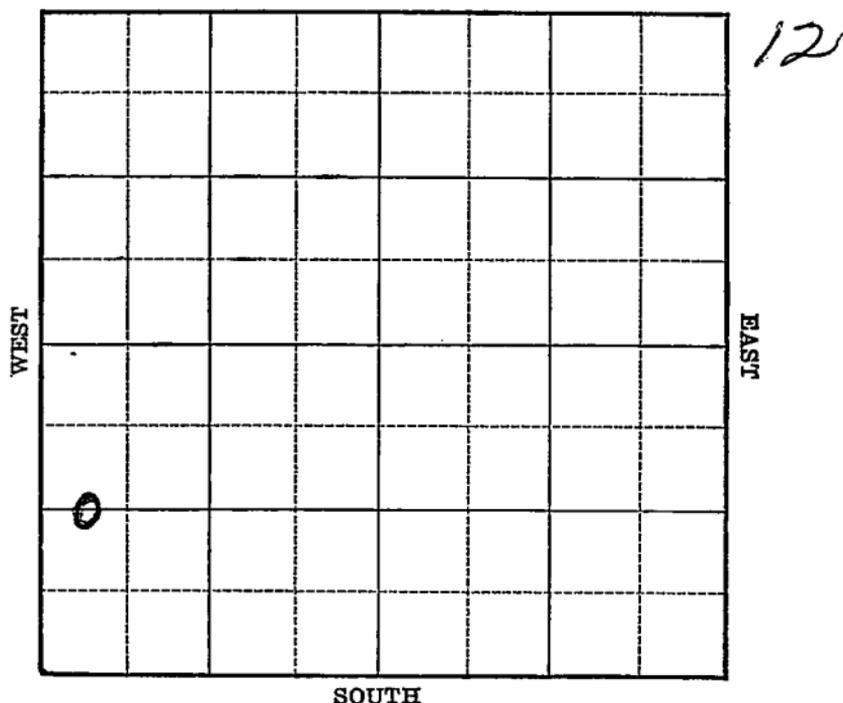

Sec. 22 Twp. 17 R. 8-W

Well No. #2 R. Janzen Farm

Continental et al Company

(Edwards)


 Ft. from N. Line

1320 Ft. from S. Line

 Ft. from E. Line

440 Ft. from W. Line

Elev. 1790

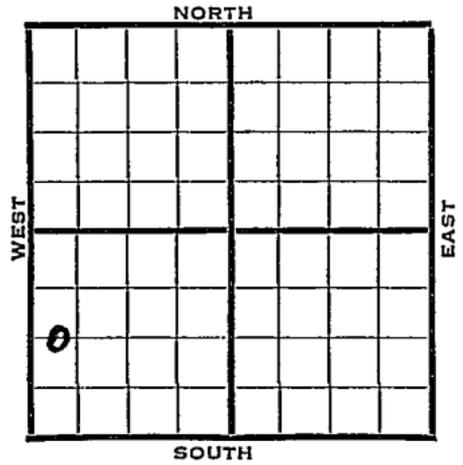

1940	REPORT
3/27	Derrick.
4/4	"
4/12	10" - 193' Drlg. 1990'
4/18	Arb. 3221-34' T.D. 7" - 3231' RUST.
4/25	At 3238' 3050' oil. T.D. 3240' 3060' oil.
5/1	Arb. 3231' 7" - 3231' T.D. 3240' Potential 1062 bbls., pump.

COMPLETED

Map No. 45 Sec. 22 Twp. 17 R. 8W

Well No. 2 R. Janzen

Continental etal Company

COMPLETED Contractor

C W L SW

 Ft. from N. Line

1320 Ft. from S. Line

 Ft. from E. Line

440 Ft. from W. Line

SECTION PLAT

EDWARDS POOL

Location

Rig up

Drilling and Remarks:

Case 3231

7" C 3231

Pump 1062 P.Y.

RECORD

Cased in., ft.

Sand

Gas

Oil

Total Depth 3240

PRODUCTION

1st 24 hrs. Nat.

1st 24 hrs. after shot

Gas Cu. Ft.

Dry Hole

Abandoned

Date

MAY 1 1940 19

S. J. LEWIS Scout