


Section 22 Township 17 Range 8W

Well No. #1 Janzen


Company Continental et al

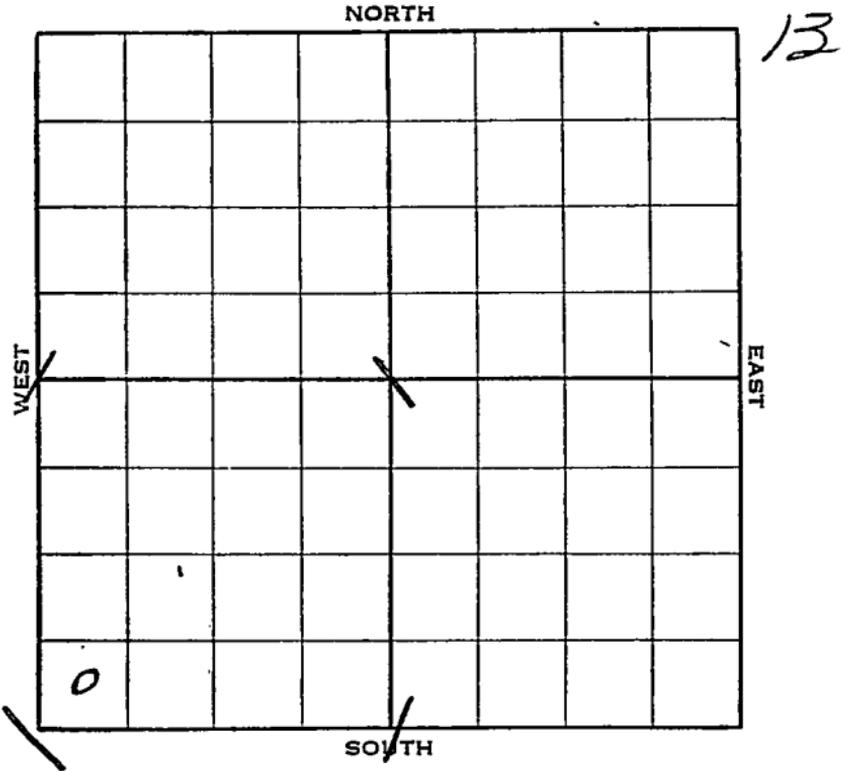

Sec. 22 Twp. 17 R. 8-W

Well No. #1 Jansen Farm
Continental et al Company

_____ Ft. from N. Line
440 Ft. from S. Line
 _____ Ft. from E. Line
440 Ft. from W. Line

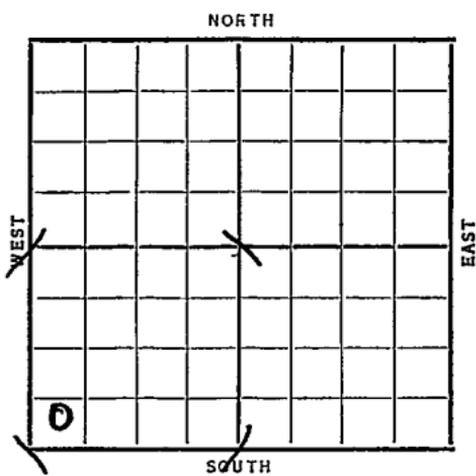

Elev. 1796


Date	REPORT
1938	
8/3	R.R.
8/12	10" - 207'. Dlg. 2360'.
8/19	Arb. 3210'. T.D. 3213'. S. O. 7" - 3211'.
8/26	Dlg. 3233'. 2800' oil.
9/2	T. D. 3250'. 3100' oil.
9/7	Arb. 3210'.
	T. D. 3250'.
	Potential pump 1833 bbls.
	COMPLETED

Map No. 45 Sec. 22 Twp. 17 R. 8WWell No. 1 JanzenContinental etal Company

Contractor

FIRST REPORT
SW/C

SECTION PLAT

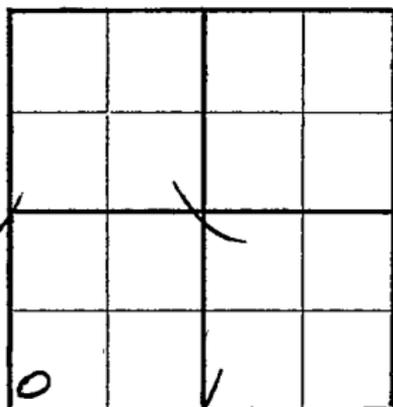

_____ Ft. from N. Line

440 Ft. from S. Line

_____ Ft. from E. Line

440 Ft. from W. Line

Location _____

Rig up _____

Drilling and Remarks:

RR

RECORD

Cased _____ in., _____ ft.

Sand _____

Gas _____

Oil _____

Total Depth _____

PRODUCTION

1st 24 hrs. Nat. _____

1st 24 hrs. after shot _____

Gas _____ Cu. Ft.

Dry Hole _____

Abandoned _____

Date

AUG 3 - 1938

19

H. D. Hatfield

Scout

Map No. 45 Sec. 22 Twp. 17 R. 8W

Well No. 1 Janzen

Continental etal Company

Contractor

COMPLETED

SW/C

SECTION PLAT

0			

_____ Ft. from N. Line

440 Ft. from S. Line

_____ Ft. from E. Line

440 Ft. from W. Line

Location _____

Rig up _____

Drilling and Remarks:

*potential
1833 Hb
pumps*

RECORD

Cased _____ in., _____ ft.

Sand Druckle 3210

Gas _____

Oil _____

Total Depth 3250

PRODUCTION

1st 24 hrs. Nat. _____

1st 24 hrs. after shot _____

Gas _____ Cu. Ft.

Dry Hole _____

Abandoned _____

Date

SEP 7 - 1938

19

ORVAL MANNSCHRECK
Scout