


DX 78-1 Ellsworth

KANSAS

Section 22 Township 17 Range 8W

Well No. #1 Janzen

Company Dozier Oil

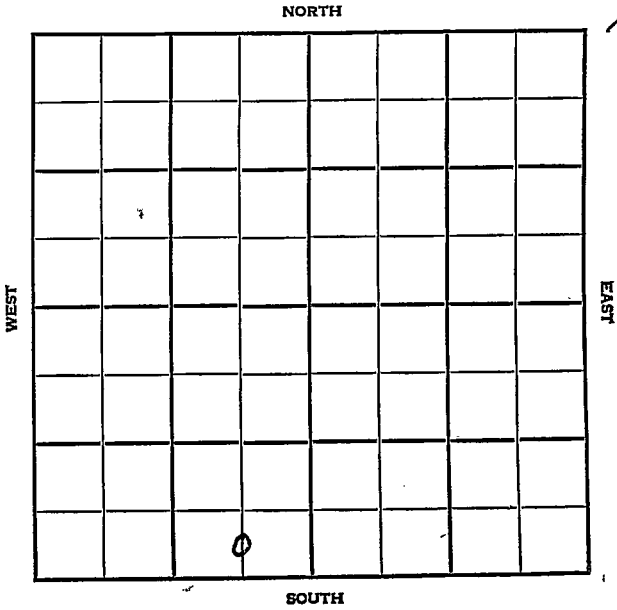

SEC. 22	TWP. 17	R. 8W
------------	------------	----------


WELL NO. #1 Janzen FARM

COMPANY Dozier Oil

CONTRACTOR Stag

Geneseo-Edwards Pool

\_\_\_\_\_ Ft. from N. Line  
 330 \_\_\_\_\_ Ft. from S. Line  
 660 \_\_\_\_\_ Ft. from E. Line  
 \_\_\_\_\_ Ft. from W. Line

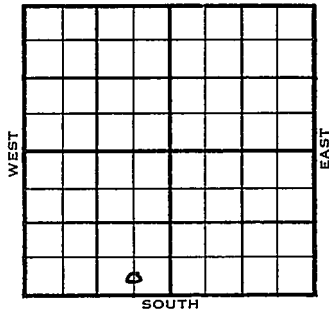

C S $\frac{1}{2}$  SE SW

	ELEVATION	REPORT
1954	1785'	
11/11	Spud 11-8-54 8" @ 224' WOC.	
11/23	Spud 11-8-54 D & A TD 3261 8" @ 224' Heeb 2700 Br. lime 2820 Lans. 2842 Cong. 3206 Simp. 3221 Arb. 3255 TD 3257 5" @ 3256 CO to 3257 S/1 $\frac{1}{4}$ BFPH DD 3261 S/11 BWPH D & A	
	<b>ABANDONED</b>	



