

KANSAS

Ellsworth

Form 51-5M-7-40-Palace

Section 22 Township 17 Range 8-W

Well No. 3 Janzen

Company Continental et al


Edwards Pool

NORTH

WEST

EAST

SOUTH

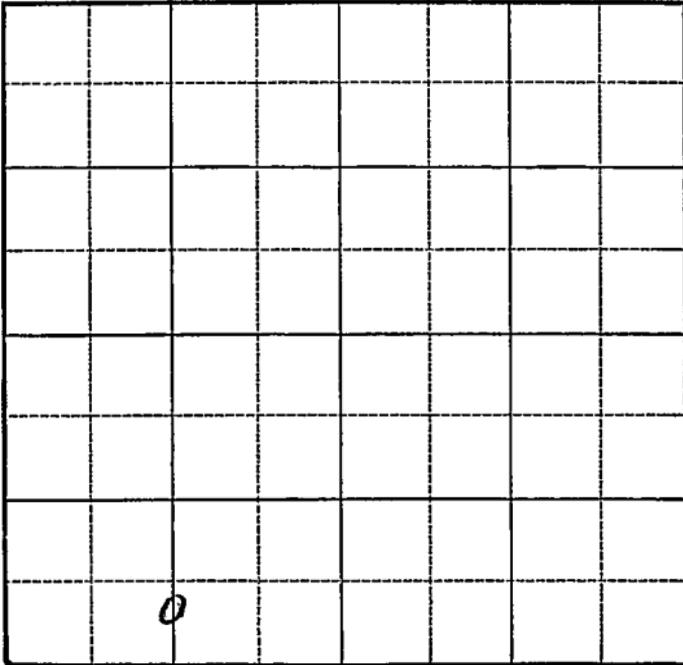

Sec. 22 Twp. 17 R. 8-W

Well No. #3 Janzer Farm _____

Continental et al Company _____

(Edwards)


_____ Ft. from N. Line

440 Ft. from S. Line

_____ Ft. from E. Line

1320 Ft. from W. Line

Elev. 1786

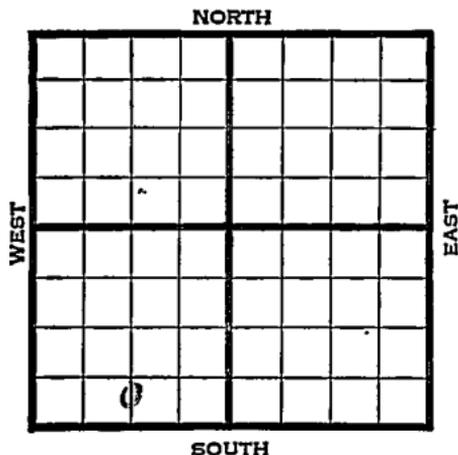

1941	REPORT
1/8	S. H.
1/16	10" - 212' Drlg. 2430'
1/23	Arb. 3234-37' TD 6" - 3235' RUST.
1/30	T.D. 3246' 2000 acid.
2/5	Arb. 3234' 6" - 3235' T.D. 3246' 2000 acid. Echometer potential 7070 bbls. Maximum 3000 bbls. 39.6 Gravity
	COMPLETED

Map No. 45 Sec. 22 Twp. 17 R. 8WWell No. 3 JanzenContinental etal

Company

FIRST REPORT

Contractor

C S L SW

_____ Ft. from N. Line

440 Ft. from S. Line

_____ Ft. from E. Line

1320 Ft. from W. Line**SECTION PLAT**

EDWARDS POOL

Location _____

Rig up _____

Drilling and Remarks:

S. H.

RECORD

Cased _____ in., _____ ft.

Sand _____

Gas _____

Oil _____

Total Depth _____

PRODUCTION

1st 24 hrs. Nat. _____

1st 24 hrs. after shot _____

Gas _____ Cu. Ft.

Dry Hole _____

Abandoned _____

Date

JAN 8 1941 19

S. J. LEWIS

Scout

