

KANSAS

Form 51—5M—7-40—Palace


Ellsworth

Section 22 Township 17 Range 8-W

Well No. #4 Janzen

Company Continental et al

NORTH Geneseo Pool

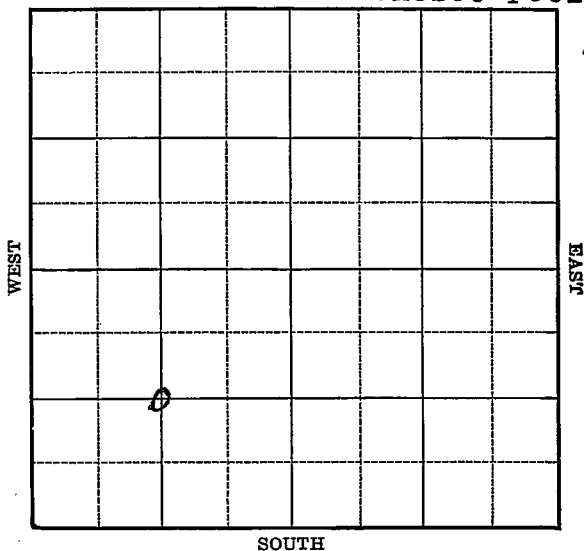


Sec. 22 Twp. 17 R. 8-WWell No. #4 Janzen FarmContinental et al Company

(Geneseo)

 Ft. from N. Line1320 Ft. from S. Line Ft. from E. Line1376 Ft. from W. Line

Elev. 1789

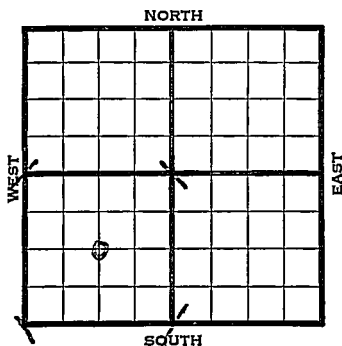

1941

REPORT

3/26

Derrick.

4/2

10" - 208' Drlg. 2425'

4/10

Arb. 3264-67' T.D. 5" - 3265'

RUST.

4/16

Arb. 3264'

T.D. 3267'

Pump 557 bbls.

40.1 Gravity


COMPLETED

Map No. 45 Sec. 22 Twp. 17 R. 8WWell No. 4 JanzenContinental etal Company**FIRST REPORT** Contractor

C SW

 Ft. from N. Line1320 Ft. from S. Line Ft. from E. Line1376 Ft. from W. Line

GENESEO POOL

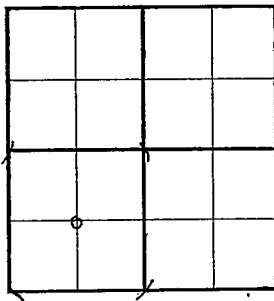SECTION PLATLocation Rig up

Drilling and Remarks:

Derrick

RECORDCased in., ft.Sand Gas Oil Total Depth **PRODUCTION**1st 24 hrs. Nat. 1st 24 hrs. after shot Gas Cu. Ft.Dry Hole Abandoned

Date

MAR 26 1941 19S. J. LEWIS Scout

Map No. 45 Sec. 22 Twp. 17 R. 8WWell No. 4 JanzenContinental etal Company


Contractor

COMPLETED

C SW

 Ft. from N. Line1320 Ft. from S. Line Ft. from E. Line1376 Ft. from W. Line

GENESEO POOL

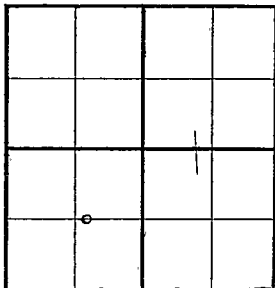SECTION PLATLocation Rig up

Drilling and Remarks:

*Rump 557 fbs**40.1 Grav.***RECORD**Cased in. ft.Sand *subsurface 3264*Gas Oil Total Depth *3267***PRODUCTION**1st 24 hrs. Nat. 1st 24 hrs. after shot Gas Cu. Ft.Dry Hole Abandoned

Date

APR 16 1949 19 S. J. LEWIS Scout