

Ellsworth County

Edwards


FORM 51 IOM, 12-46 PETROL

KANSAS

Section 22 Township 17 Range 8W

Well No. 6 R. Janzen

Company Continental

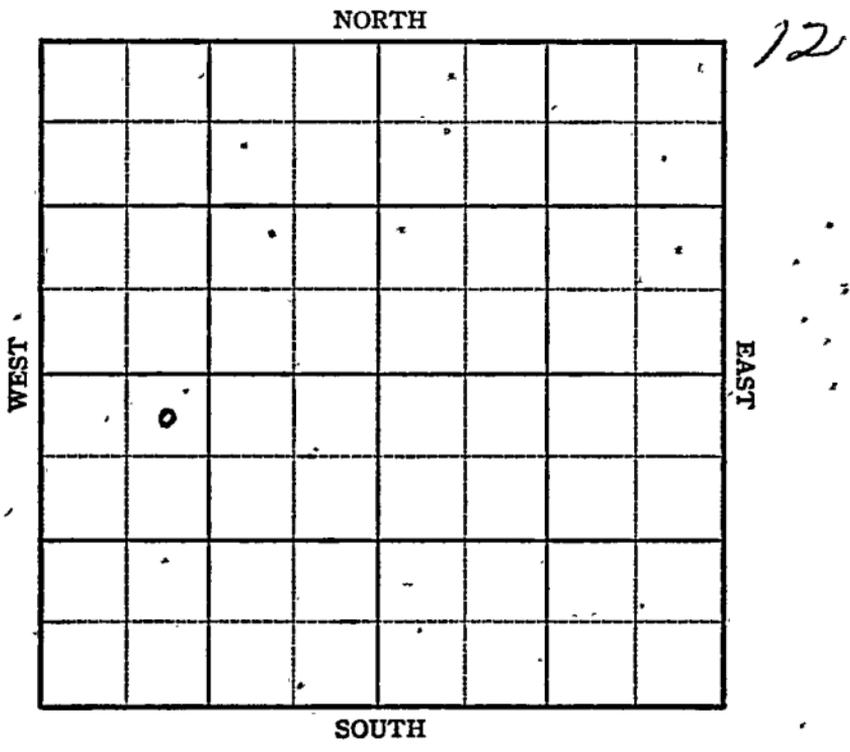

Sec. 22 Twp. 17 R. 8-W

Well No. #6 R. Janzen Farm


Continental Company
Edwards

330 Ft. from N. Line

_____ Ft. from S. Line

_____ Ft. from E. Line

990 Ft. from W-Line

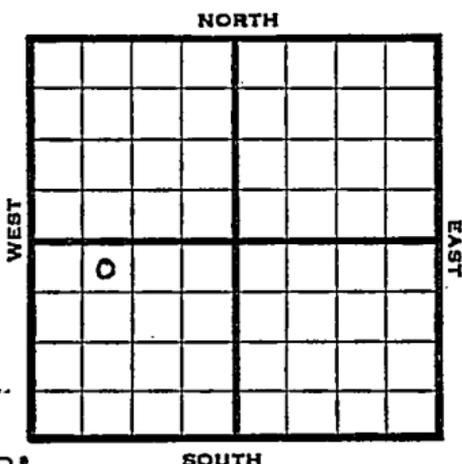

NE NW SW Elev. 1792'

REPORT

1947

3/5 Derrick

3/11 RUR

3/18 10" @ 255'
Drlg 2250'

3/25 Drlg 3255'

4/2 Lansing 2820'
Arbuckle 3257' -61' TD
5" @ 3258'
2700' oil.

4/9 Arb 3257
5" @ 3259
Depth Pot 1768' oil & 765 W
Grav. 39
TD 3261'

COMPLETED

Map No. 45 Sec. 22 Twp. 17 R. 8W

Well No. 6 R. Janzen

Continental Company

FIRST REPORT

Contractor

NE NW SW

SECTION PLAT

330 Ft. from N. Line

_____ Ft. from S. Line

_____ Ft. from E. Line

990 Ft. from W. Line

o			

Ellsworth County

Location _____

Rig up _____

Drilling and Remarks:

Derrick

RECORD

Cased _____ in., _____ ft.

Sand _____

Gas _____

Oil _____

Total Depth _____

PRODUCTION

1st 24 hrs. Nat. _____

1st 24 hrs. after shot _____

Gas _____ Cu. Ft.

Dry Hole _____

Abandoned _____

Date

MAR 5 1947 19

S. J. LEWIS

Scout

Kansas
KANSASMap No. K45 Sec. 22 Twp. 17 R. 8WWell No. 6 R. JanzenContinental Company

COMPLETE

Contractor

NE NW SW

E. J. 1992

SECTION PLAT

330 Ft. from N. Line

_____ Ft. from S. Line

_____ Ft. from E. Line

990 Ft. from W. Line

△			

Ellsworth County

Location _____

Rig up _____

Drilling and Remarks:

*Cent 2259**5" 2259**Depth 1765 in**F 765 W**27 2/3*

RECORD

Cased _____ in., _____ ft.

Sand _____

Gas _____

Oil _____

Total Depth 9261

PRODUCTION

1st 24 hrs. Nat. _____

1st 24 hrs. after shot _____

Gas _____ Cu. Ft.

Dry Hole _____

Abandoned _____

Date

APR 9 1947 19

S. J. LEWIS Scout