
Ellsworth KANSAS

FORM SI 5M PETROL

Section 22 Township 17- Range 8-W

Well No. #1 Williams

Company Nelson Drlg et al

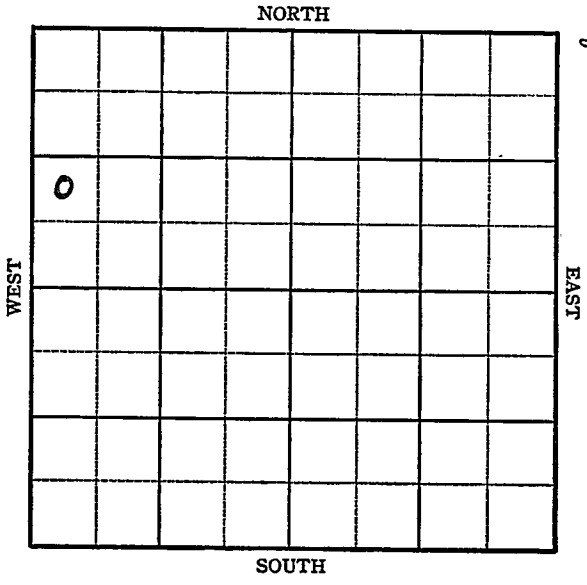


FORM 252-A
5M 8-45 PETROL

KANSAS Ellsworth

Sec. 22 Twp. 17 R. 8-W

Well No. #1 Williams Farm

Nelson Drlg. et al Company

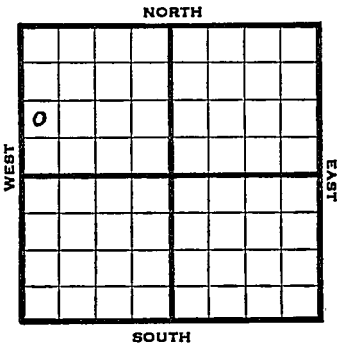

_____ Ft. from N. Line

990 Ft. from S. Line

_____ Ft. from E. Line

330 Ft. from W. Line

NW SW NW

1945	Elev. 1806'	REPORT
12/12	RUR	
12/20	8" - 195'	Drlg. 2445'
12/29	Lans 2835'	Arb. 3242'
	T.D. 3246'	5" - 3242' RUST.
1946		
1/10	T.D. 3253'	3000 acid.
	Testing.	
1/17	T.D. 3259'	1400' oil, Trace water.
1/24	" "	"
1/31	" "	"
2/7	" "	"
2/13	Arb. 3242	
	5" @ 3242	
	3000 acid.	
	TD 3259'	
	Pump 21 Pot.	
	Grav. 39.6	

COMPLETED

FORM 26 200 BKS. 2-44 PETROL

KANSAS Kansas Pool Name Edwards

Map No. K-40 Sec. 22 Twp. 17 R. 8W


Well No. 1 Williams

Nelson Drlg. etal Company

FIRST REPORT Contractor

W SW NW

SECTION PLAT

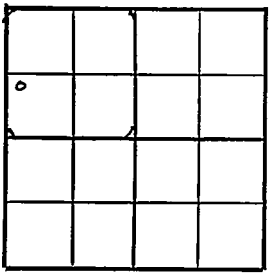

____ Ft. from N. Line

990 Ft. from S. Line

____ Ft. from E. Line

330 Ft. from W. Line

Ellsworth County

Location

Rig up

Drilling and Remarks:
RUR

RECORD

Cased ____ in., ____ ft.

Sand

Gas

Oil

Total Depth

PRODUCTION

1st 24 hrs. Nat.

1st 24 hrs. after shot

Gas ____ Cu. Ft.

Dry Hole

Abandoned

Date

DEC 12 1945 19

S. J. LEWIS Scout

FORM 26 2-50 BKS. 2-44 PETROL

KANSAS Kansas Pool Name Edwards

Map No. 45 Sec. 22 Twp. 17 R. 8W

Well No. 1 Williams


Nelson Drlg. etal Company

COMPLETED Contractor

NW SW NW

El. 1806

SECTION PLAT

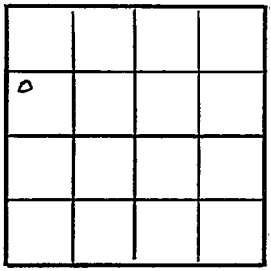

____ Ft. from N. Line

990 Ft. from S. Line

____ Ft. from E. Line

330 Ft. from W. Line

Ellsworth County

Location

Rig up

Drilling and Remarks:

RTD 3242

5" to 3242

800 cem'd

Pump 2½ Bbl.

39 Gr

RECORD

Cased ____ in., ____ ft.

Sand

Gas

Oil

Total Depth 3209

PRODUCTION

1st 24 hrs. Nat.

1st 24 hrs. after shot

Gas ____ Cu. Ft.

Dry Hole

Abandoned

Date

FEB 13 1946 19

S. J. LEWIS Scout