

KANSAS


Ellsworth county

FORM 51 5M 11-44 PETROL

Section 22 Township 17 Range 8W

Well No. #2, Williams

Company Nelson Drlg.

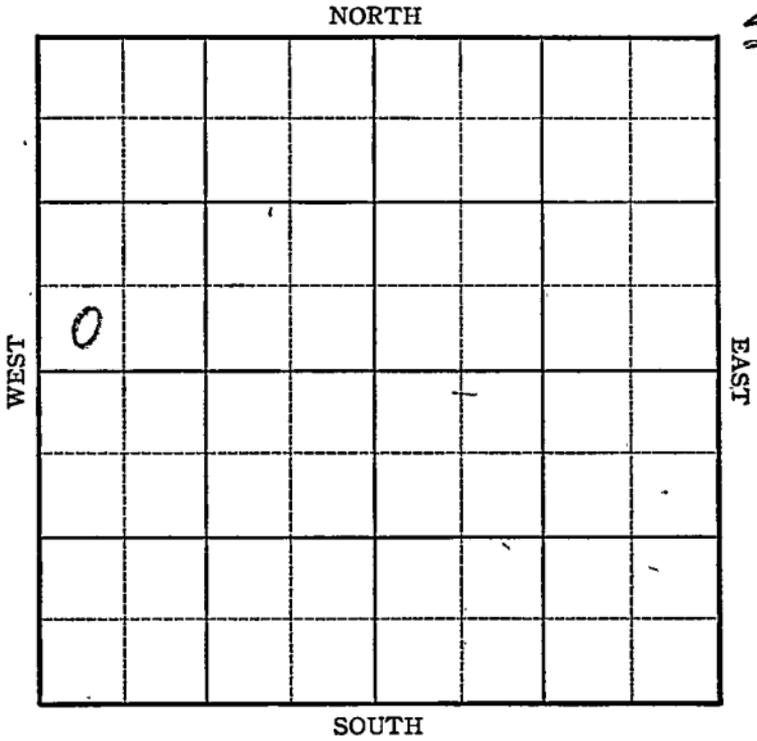

Sec. 22 Twp. 17 R. 8W

Well No. #2 Williams Farm

Nelson Drlg. Company


Edwards

_____ Ft. from N. Line

330 _____ Ft. from S. Line

_____ Ft. from E. Line

330 _____ Ft. from W. Line

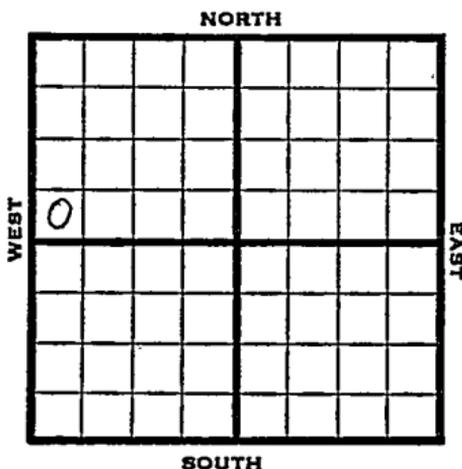

SW NW

1946 Elev. 1801 REPORT

- 4/3 10" @ 174' WOC
- 4/10 Drlg 3020
- 4/16 Lans 2820
- Simp 3202
- Arb 3246-48
- TD 7" @ 3246 RUST
- TD 3256-2200 fluid
- 4/24 Arb. 3246
- 7" @ 3246
- 1000 acid.
- TD 3256'
- Echo Pot. 3000
- Grav. 39.6

COMPLETED

Pool Name Edwards
 Map No. 25 Sec. 22 Twp. 17 R. 8W
 Well No. 2 Williams

KANSAS Kansas
 Nelson Drig.
FIRST REPORT

Company _____
 Contractor _____

SW NW

SECTION PLAT

_____ Ft. from N. Line
 '330 Ft. from S. Line
 _____ Ft. from E. Line
 330 Ft. from W. Line

Ellsworth County

Location _____

Rig up _____

Drilling and Remarks:

10" @ 174 WOC

RECORD

Cased _____ in., _____ ft.
 Sand _____
 Gas _____
 Oil _____
 Total Depth _____

PRODUCTION

1st 24 hrs. Nat. _____
 1st 24 hrs. after shot _____
 Gas _____ Cu. Ft.
 Dry Hole _____
 Abandoned _____

Date

APR 3 1946 19

S. J. LEWIS

Scout

KANSAS " Kansas, Pool Name Edwards

Map No. 43 Sec. 22 Twp. 17 R. 8W

Well No. 2 Williams

Nelson Drlg. Company

COMPLETED

Contractor

SW NW

E11801

SECTION PLAT

_____ Ft. from N. Line

330 Ft. from S. Line

_____ Ft. from E. Line

330 Ft. from W. Line

<u>0</u>			

Ellsworth County

Location _____

Rig up _____

Drilling and Remarks:

*Cor 3246
7" @ 3246
1000 acid
Echo Prod 3000
396/2*

RECORD

Cased _____ in., _____ ft.

Sand _____

Gas _____

Oil _____

Total Depth 3256

PRODUCTION

1st 24 hrs. Nat. _____

1st 24 hrs. after shot _____

Gas _____ Cu. Ft.

Dry Hole _____

Abandoned _____

Date

APR 24 1946

19

S. J. LEWIS

Scout