

Sec. 22 **KANSAS** Twp. 17 R. 8W

Well No. 4 Williams Farm

N C R A

Company

Edwards Pool

Ft. from N. Line


990

Ft. from S. Line

Ft. from E. Line

990

Ft. from W. Line

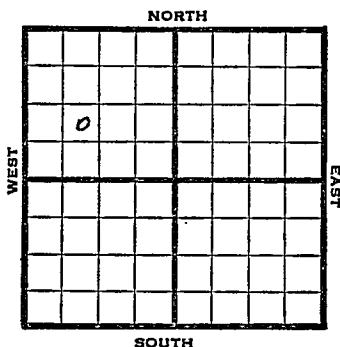

NE SW NW. 36

1947 Elev. 1804' REPORT

5/7	Location
5/13	"
5/20	10" @ 193' Drlg 2483'
5/27	Simpson 3210' Arbuckle 3252' TD 3254' 7" @ 3253' RUST
6/3	" "
6/10	TD 3256 $\frac{1}{2}$ 1000 acid
6/18	Arb. 3252' 7" @ 3253' 1000 Acid Depth Pot 3000 45.0 Gr. TD 3256 $\frac{1}{2}$ '

COMPLETED

Map No. 145 Sec. 22 Twp. 17 R. 8WWell No. 4 Williams

N C R A

Company

FIRST REPORT

Contractor

NE SW NW

SECTION PLAT

o			

 Ft. from N. Line990 Ft. from S. Line Ft. from E. Line990 Ft. from W. Line

Ellsworth County

Location XRig up

Drilling and Remarks:

RECORD

Cased in., ft.Sand Gas Oil Total Depth

PRODUCTION

1st 24 hrs. Nat. 1st 24 hrs. after shot Gas Cu. Ft.Dry Hole Abandoned

Date

MAY 7 1947

19

S. J. LEWIS Scout

Map No. 45 Sec. 22 Twp. 17 R. 8WWell No. 4 WilliamsN C R A CompanyCOMPLETE Contractor

NE SW NW

E1.1804
SECTION PLAT Ft. from N. Line990 Ft. from S. Line Ft. from E. Line990 Ft. from W. Line

△			

Ellsworth CountyLocation Rig up

Drilling and Remarks:

CR 80252
7" CR 253
1000 feet
Depth 8000

45° Gr

RECORD

Cased in., ft.Sand Gas Oil Total Depth 256 1/2

PRODUCTION

1st 24 hrs. Nat. 1st 24 hrs. after shot Gas Cu. Ft.Dry Hole Abandoned

Date

JUN 18 1947 19S. J. LEWIS

Scout