

KANSAS

FORM 51 5M 11-44 PETROL

McPherson county

Section 22 Township 17 Range 1W

Well No. W1, Wheatley

Company B & R Drlg.

NORTH

							0

SOUTH

WEST

EAST

8

KANSAS

McPherson County ✓

Sec. 22 Twp. 17 R. 1W

Well No. #1 Wheatley Farm

B & R Drlg. Company

Crowther


 Ft. from N. Line

330 Ft. from S. Line

330 Ft. from E. Line

 Ft. from W. Line

SE NE

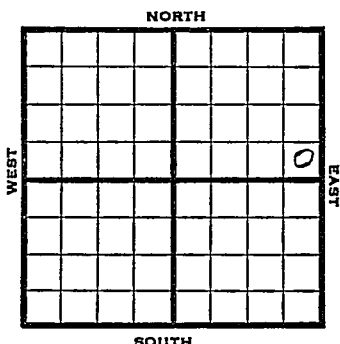

1946 Elev. 1422 REPORT

4/10 Location

4/16 8" @ 150 Drlg 1510

4/23 Drlg 2667'

5/1 Miss. 2758
TD 2790'

ABANDONED

Pool Name Crowther

KANSAS

Kansas

Map No. 42 Sec. 22 Twp. 17 R. 1WWell No. 1 WheatleyB & R Drlg.


Company

FIRST REPORT

Contractor

SE NE

SECTION PLAT

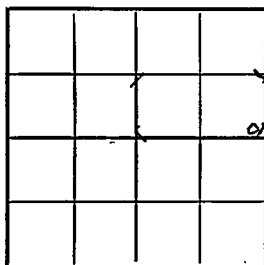 Ft. from N. Line330 Ft. from S. Line330 Ft. from E. Line Ft. from W. LineMcPherson CountyLocation XRig up

Drilling and Remarks:

RECORD

Cased in., ft.Sand Gas Oil Total Depth

PRODUCTION

1st 24 hrs. Nat. 1st 24 hrs. after shot Gas Cu. Ft.Dry Hole Abandoned

Date

APR 10 1946 19 S. J. LEWIS Scout

Kansas Pool Name Crowther PoolKANSAS
Map No. 72 Sec. 22 Twp. 17 R. 1WWell No. 1 Wheatley

B & R Drlg.

Company

ABANDONED

Contractor

SE NE

E11422
SECTION PLAT

			0

 Ft. from N. Line330 Ft. from S. Line330 Ft. from E. Line Ft. from W. LineMcPherson CountyLocation Rig up

Drilling and Remarks:

Mus 2708

RECORD

Cased in., ft.Sand Gas Oil Total Depth 2790

PRODUCTION

1st 24 hrs. Nat. 1st 24 hrs. after shot Gas Cu. Ft.Dry Hole Abandoned

Date

MAY 1 1946 19

S. J. LEWIS Scout